

**LANDLORD'S REQUIRED SUBCONTRACTOR LIST**

NOTE: THE FOLLOWING SUBCONTRACTORS ARE REQUIRED BY THE LANDLORD TO BE USED BY THE TENANT G.C. VERIFY ALL REQUIRED LANDLORD SUB-CONTRACTORS WITH LANDLORD PRIOR TO BIDDING PROJECT.

**CONCRETE SLAB**  
Rick Hamm Construction, Inc.  
201 W. Carlton Avenue  
Orange, CA 92667  
Rick Hamm  
rick@rickhamm.com  
Ph: 714.532.0815  
Toll Free: 800.742.4266  
Cell: 714.931.8475

**STOREFRONT (NO LONGER REQUIRED)**  
Huntington Glazing  
5344 Alhambra Ave.  
Los Angeles, CA 90032  
Gabriel Velez  
gvelez@huntingtonglazing.net  
323.353.4431 cell

**LOCKSMTIH**  
Tony's Locksmith  
429 Avenida de la Estrella  
San Clemente, CA 92672  
Type: 6 pin Schlage  
Eric Smith  
Eric.r.smith@cox.net  
Ph: 949.492.5700  
Cell: 949.436.0467

**WASTE REMOVAL / DUMPSTER**  
CR&R  
31641 Ortega Highway  
San Juan Capistrano, CA 92693  
Maria Lazarik  
Ph: 714.372.8288  
Toll Free 877.728.0446

**ROOFING**  
Diamond Roofing  
34 Indian Pipe  
Dove Canyon, CA 92679  
Tom Berry  
tom@diamondroofing.com  
Dir: 949.298.3212  
Fax: 949.298.3206  
Cell: 949.683.2000

**ROOFING**  
FIRE LIFE SAFETY & FIRE SPRINKLER:  
Nutech Fire Alarm & Security  
11223 Old River School Rd  
Downey, CA 90241  
Jesse Hernandez  
jhernandez@gmsnutech.com  
Dir: 562.946.3473  
Fax: 562.946.3474  
Cell: 562.307.1743

**ABBREVIATIONS**

A.B.	ANCHOR BOLT	MAX.	MAXIMUM
A.F.F.	ABOVE FINISH FLOOR	MFG.	MANUFACTURER
&	AND	MIN.	MINIMUM
ALUM.	ALUMINUM	MISC.	MISCELLANEOUS
ARCH	ARCHITECTURAL	M.O.	MASONRY OPENING
@	AT	MTD.	MOUNTED
BLDG.	BUILDING	N.I.C.	NOT IN CONTRACT
B.O.	BOTTOM OF	NO.	NUMBER
BRG.	BEARING	NTS.	NOT TO SCALE
∅	CENTER LINE	O.C.	ON CENTER
CFM.	CUBIC FEET PER MINUTE	O.D.	OUTSIDE DIAMETER
C.J.	CONTROL JOINT	OPNG.	OPENING
CLR.	CLEAR	OPP.	OPPOSITE
CMU.	CONCRETE MASONRY UNITS	O.S.B.	ORIENTED STRAND BOARD
COL.	COLUMN	P.L.F.	POUNDS PER LINEAL FOOT
CONC.	CONCRETE	P.S.I.	POUNDS PER SQUARE INCH
CONT.	CONTINUOUS	RE.	REFER TO, REFERENCE FROM
CYL.	CYLINDER	REIN.	REINFORCING
DN.	DOWN	REQD	REQUIRED
∅	DIAMETER	R.O.	ROUGH OPENING
EA.	EACH	SIM.	SIMILAR
ELEV.	ELEVATION	SPECS.	SPECIFICATIONS
E.I.F.S.	EXTERIOR INSULATING FINISH SYSTEM	STL.	STRUCTURAL
		SQ.	SQUARE
		VERT.	VERTICAL
FDN.	FOUNDATION		
F.O.C.	FACE OF CURB / CONCRETE		
F.O.M.	FACE OF MASONRY	T&G	TONGUE & GROOVE
FIN.	FINISH	T.O.C.	TOP OF CURB/CONCRETE
FLR.	FLOOR	T.O.P.	TOP OF
FT.	FEET	T.D.	TOP OF DRAIN
FTG.	FOOTING	T.E.	TRASH ENCLOSURE
FR-S		TYP.	TYPICAL
GA.	GAUGE		
GALV.	GALVANIZED	U.D.L.	UNIFORM DISTRIBUTED LOAD
G.I.	GALVANIZED IRON / STEEL	U.N.O.	UNLESS NOTED OTHERWISE
G.L.	GLUE LAMINATED STRUCTURE MEMBER		
GYP. BRD.	GYP SUM BOARD		
H.C.A.	HEADED CONCRETE ANCHOR	WI	WITH
H.M.	HOLLOW METAL	W.P.	WEATHERPROOF
HORIZ.	HORIZONTAL	W.W.F.	WELDED WIRE FABRIC
HR.	HOUR		
HT.	HEIGHT		
H.V. / A.C.	HEATING VENTILATION / AIR CONDITIONING		
I.D.	INSIDE DIMENSION		
IN.	INCH		
LBS.	POUNDS		
L.O.W.	LIMIT OF WORK		

**SPECIAL INSPECTION**

**DEFERRED SUBMITTALS**

**ACCESSIBILITY INSPECTED**

I AM THE DESIGNER/OWNER IN RESPONSIBLE CHARGE OF THIS TENANT IMPROVEMENT PROJECT. I HAVE INSPECTED THE SITE/PREMISES AND DETERMINED THAT EXISTING CONDITIONS ARE IN FULL COMPLIANCE WITH CURRENT SITE ACCESSIBILITY REQUIREMENTS TO THE EXTENT REQUIRED BY LAW.

SIGNATURE: \_\_\_\_\_

PRINT NAME: \_\_\_\_\_

DATE: \_\_\_\_\_

IF THE BUILDING INSPECTOR DETERMINES NONCOMPLIANCE WITH ANY CURRENT ACCESSIBILITY PROVISIONS OF THE LAW, HE/SHE SHALL REQUIRE SUBMITTAL OF COMPLETE AND DETAILED PLANS TO THE BUILDING DEVELOPMENT REVIEW DIVISION OF THE DEVELOPMENT SERVICES DEPARTMENT FOR FURTHER REVIEW. PLANS MUST CLEARLY SHOW ALL EXISTING NON-COMPLYING CONDITION AFFECTED BY THE REMODEL (INCLUDING SIRE PLAN, FLOOR PLAN, DETAILS, ETC.) AND PROPOSED MODIFICATIONS OF DEFICIENCIES TO MEET CURRENT ACCESSIBILITY PROVISIONS. THE PLANS MUST BE STAMPED BY THE FIELD INSPECTOR PRIOR TO SUBMITTAL FOR PLAN REVIEW.

**GRAPHIC SYMBOLS**

	DOOR NUMBER
	WINDOW TYPE
	KITCHEN EQUIPMENT NUMBER
	ROOM/SPACE NUMBER
	FURNITURE NUMBER
	MISCELLANEOUS EQUIPMENT NUMBER
	WASHROOM & KITCHEN ACCESSORIES NUMBER
	REFERENCE WALL TYPE
	SECTION/DETAIL
	WALL SECTION
	ELEVATION REFERENCE
	DETAIL REFERENCE
	TRUE NORTH
	PLAN NORTH
	FLOOR PLAN
	SCALE: 1/4" = 1'-0"
	DRAWING TITLE W/ NORTH
	ELEVATION NOTE
	REVISION NUMBER

# ATTACHMENT 9

# Westend Restaurant

## 814 WEST 19TH STREET COSTA MESA, CA. 92626



**J.C. MARVICK & ASSOC., INC.**  
ARCHITECTURE / PLANNING  
1827 Capital Street, suite 101  
Corona, Calif. 92878 951-808-0520



Drawings and Specifications as instruments of service are and shall remain the property of the Architect. The Drawings and Specifications shall not be used on other projects. For additions to this project by others except by agreement in writing with the Architect. Any use or reproduction of this drawing in whole or part by any means is strictly prohibited except with specific written consent of John C. Marvick, Architect.  
© COPYRIGHT 2023, JOHN C. MARVICK, ARCHITECT

**CODE AUTHORITIES**

BUILDING CODE	2022 CALIFORNIA BUILDING CODE
PLUMBING CODE	2022 CALIFORNIA PLUMBING CODE
MECHANICAL CODE	2022 CALIFORNIA MECHANICAL CODE
ELECTRICAL CODE	2022 CALIFORNIA ELECTRICAL CODE
FIRE CODE	2022 CALIFORNIA FIRE CODE
HEALTH CODE	2022 CALIFORNIA FOOD CODE
ENERGY CODE	2022 CALIFORNIA ENERGY CODE
ACCESSIBILITY CODE	2022 CAL GREEN ENERGY CODE REQUIREMENTS ADAAG

**SCOPE OF WORK**

THIS PROJECT CONSISTS OF A TENANT IMPROVEMENT OF AN EXISTING RESTAURANT. WE WILL BE REMOVING A BACK PATIO OF 250 S.F. AND REPLACING IT WITH A NEW COVERED BACK PATIO OF 651 S.F. WE WILL ALSO BE GETTING THE EXISTING 150 S.F. FRONT PATIO PERMITTED.

**REGULATORY AGENCIES**


Planning & Zoning Dept.	City of Costa Mesa Planning Division 77 Fair Drive Costa Mesa, Ca. 92626 Contact: Counter Technician Tel.: (714) 754-5245
Building Dept.	City of Costa Mesa Building Division 77 Fair Drive Costa Mesa, Ca. 92626 Contact: Counter Technician Tel.: (714) 754-5273
Fire Dept.	City of Costa Mesa Fire & Rescue 77 Fair Drive Costa Mesa, Ca. 92626 Contact: Counter Technician Tel.: (714) 754-5106

**BUILDING CODE & ZONING DATA**

1. OCCUPANCY GROUP:	B / A-2
2. ZONE:	COMMERCIAL
3. APN:	115-350-42
4. TRACT NO.	
5. BUILDING TYPE:	VN-B
6. WEST END RESTAURANT AREA :	
FRONT PATIO AREA :	101
INTERIOR AREA :	1,034
REAR PATIO AREA :	720
TOTAL AREA :	1,677
7. MEANS OF EGRESS:	TWO REQUIRED, TWO PROVIDED
8. FIRE SPRINKLERS:	YES
9. SEE SHEET A-0.1 FOR ALL CODE COMPLIANT AND BUILDING INFORMATION	

**DRAWING INDEX AND REVISIONS**

ARCHITECTURAL DRAWINGS	
TITLE / PROJECT INFORMATION	
T-1	SITE PLAN
SP-1.0	SITE PLAN
A-0.1	EXITING AND OCCUPANCY PLAN
A-1.0	AS-BUILT FLOOR PLAN
A-2.0	AS-BUILT ELEVATIONS
A-3.0	OVER ALL FLOOR PLAN & ENLARGED FLOOR PLANS
A-4.0	REFLECTED CEILING PLAN & ROOF PLAN
A-5.0	ELEVATIONS
A-6.0	SECTIONS AND DETAILS

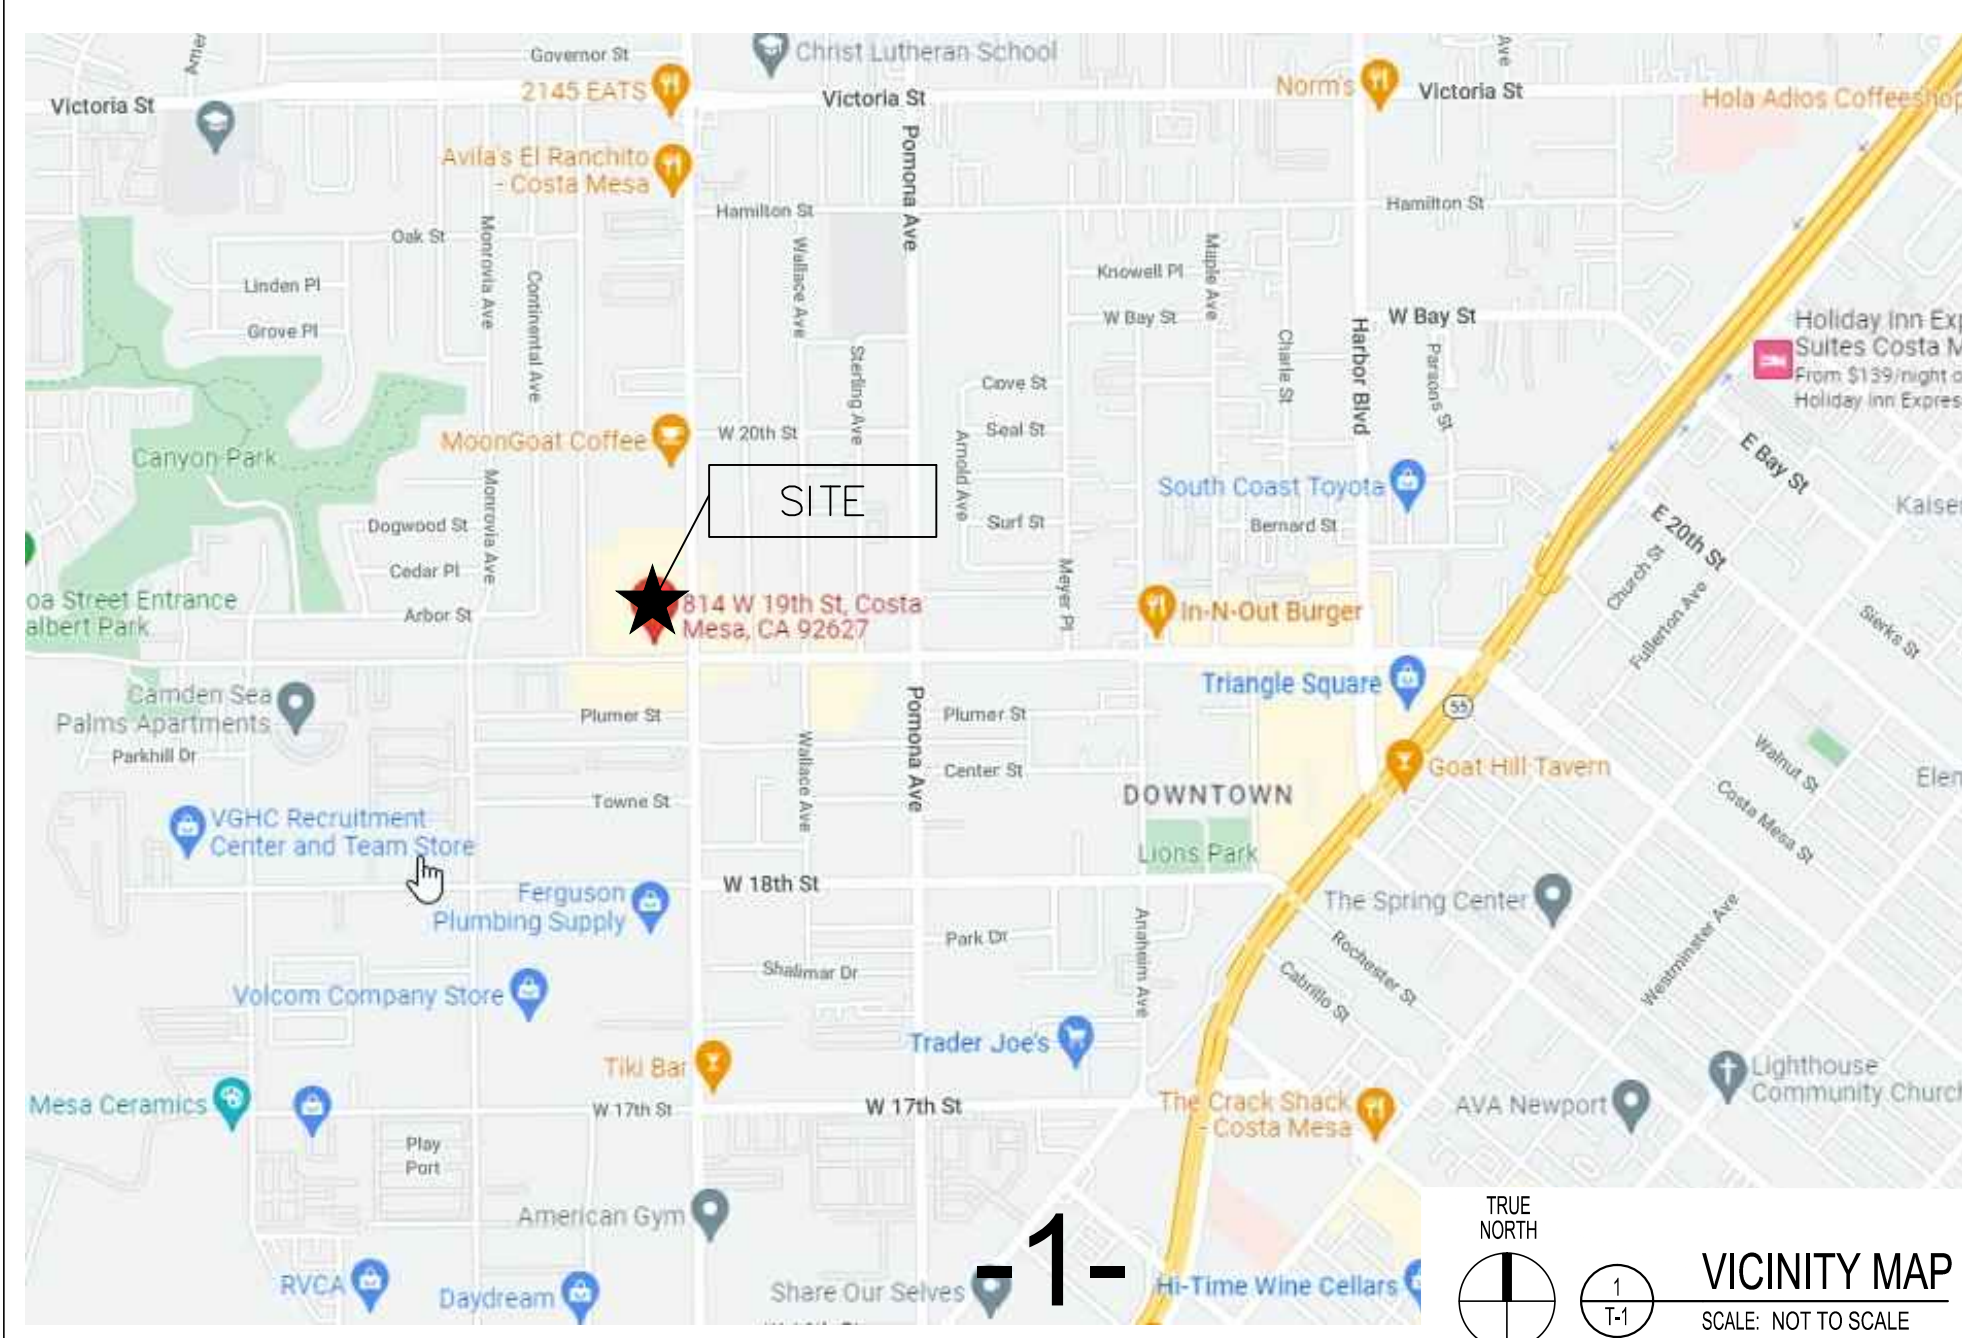

**PROJECT DIRECTORY**

<b>LANDLORD:</b> Monica Chang 7042 Kearny Dr. Huntington Beach, Ca 92658 Contact: Monica Chang Email: Tel.: (714) 357-1858 Fax:	<b>STRUCTURAL:</b> Shucri Yaghi Structural Engineering 112 E. Chapman Ave. Suite D Orange, Ca 92666 Contact: Chuck Yaghi Email: yaghi-engineers@live.com Tel.: (714) 997-9120 Fax: (714) 744-3676
<b>TENANT:</b> Westend 814 West 19th street Costa Mesa, Ca 92626 Contact: Roland Barrera Email: barrera.roland@icloud.com Tel.: (714) 290-0375	<b>MECHANICAL:</b> RPM Engineers, Inc. 102 Discovery Irvine, Ca 92618 Contact: Raymond Phua Email: rayp@rpmpe.com Tel.: (949) 450-1229 ext. 200
<b>ARCHITECT:</b> J.C. Marvick & Associates, INC. 1827 Capital Street, suite 102 Corona, Ca 92880 Contact: Chuck Marvick Email: jcmarvick@sbcglobal.net Tel.: (951) 808-0520 Fax: (951) 808-0560	

**Westend Restaurant**  
SITE IMPROVEMENT  
814 WEST 19TH STREET  
COSTA MESA, CA 92627

ISSUE RECORD:	C.U.P. SUBMITTAL
6-1-23	

DRAWN:	CHECKED:
C.M.	C.M.

PROJECT NUMBER  
22-13 WEST END RESTAURANT

SHEET TITLE  
TITLE / PROJECT INFORMATION


SHEET NUMBER  
**T-1**



OCCUPANT LOAD (AFTER DINING)				
WEST END Room Type	Area	Occupancy	S.F. / Person	Persons
COVERED REAR PATIO	334 s.f.	ASSEMBLY	5	66
BAR	51 s.f.	KITCHEN COMMERCIAL	200	1
STAGE	75 s.f.	KITCHEN COMMERCIAL	15	5
ENTRY PATIO - COVERED	35 s.f.	ASSEMBLY	15	3
FOOD PREP BBQ	66 s.f.	KITCHEN, COMMERCIAL	200	3
TOTAL AT WEST END	1,677 s.f.		TOTAL	78

Occupancy CBC Table 1004.1.1		
Occupancy S.F. Type	S.F. Per Person	S.F. Unit
BAR AREA	200	Gross
STAGE AREA	15	Gross
PUBLIC ASSEMBLE AREA	15	Gross
PUBLIC ASSEMBLE STANDING	5	Gross
STORAGE / STOCK	300	Gross


OCCUPANT LOAD (DINING HOURS)				
WEST END Room Type	Area	Occupancy	S.F. / Person	Persons
COVERED REAR PATIO	542 s.f.	ASSEMBLY	15	36
HALL	-	-	-	-
ENTRY PATIO - COVERED	35 s.f.	ASSEMBLY	15	3
FOOD PREP BBQ	66 s.f.	KITCHEN, COMMERCIAL	200	3
INTERIOR SPACE - NO CHANGES	1,034 s.f.	-	-	22
TOTAL AT WEST END	1,677 s.f.		TOTAL	64

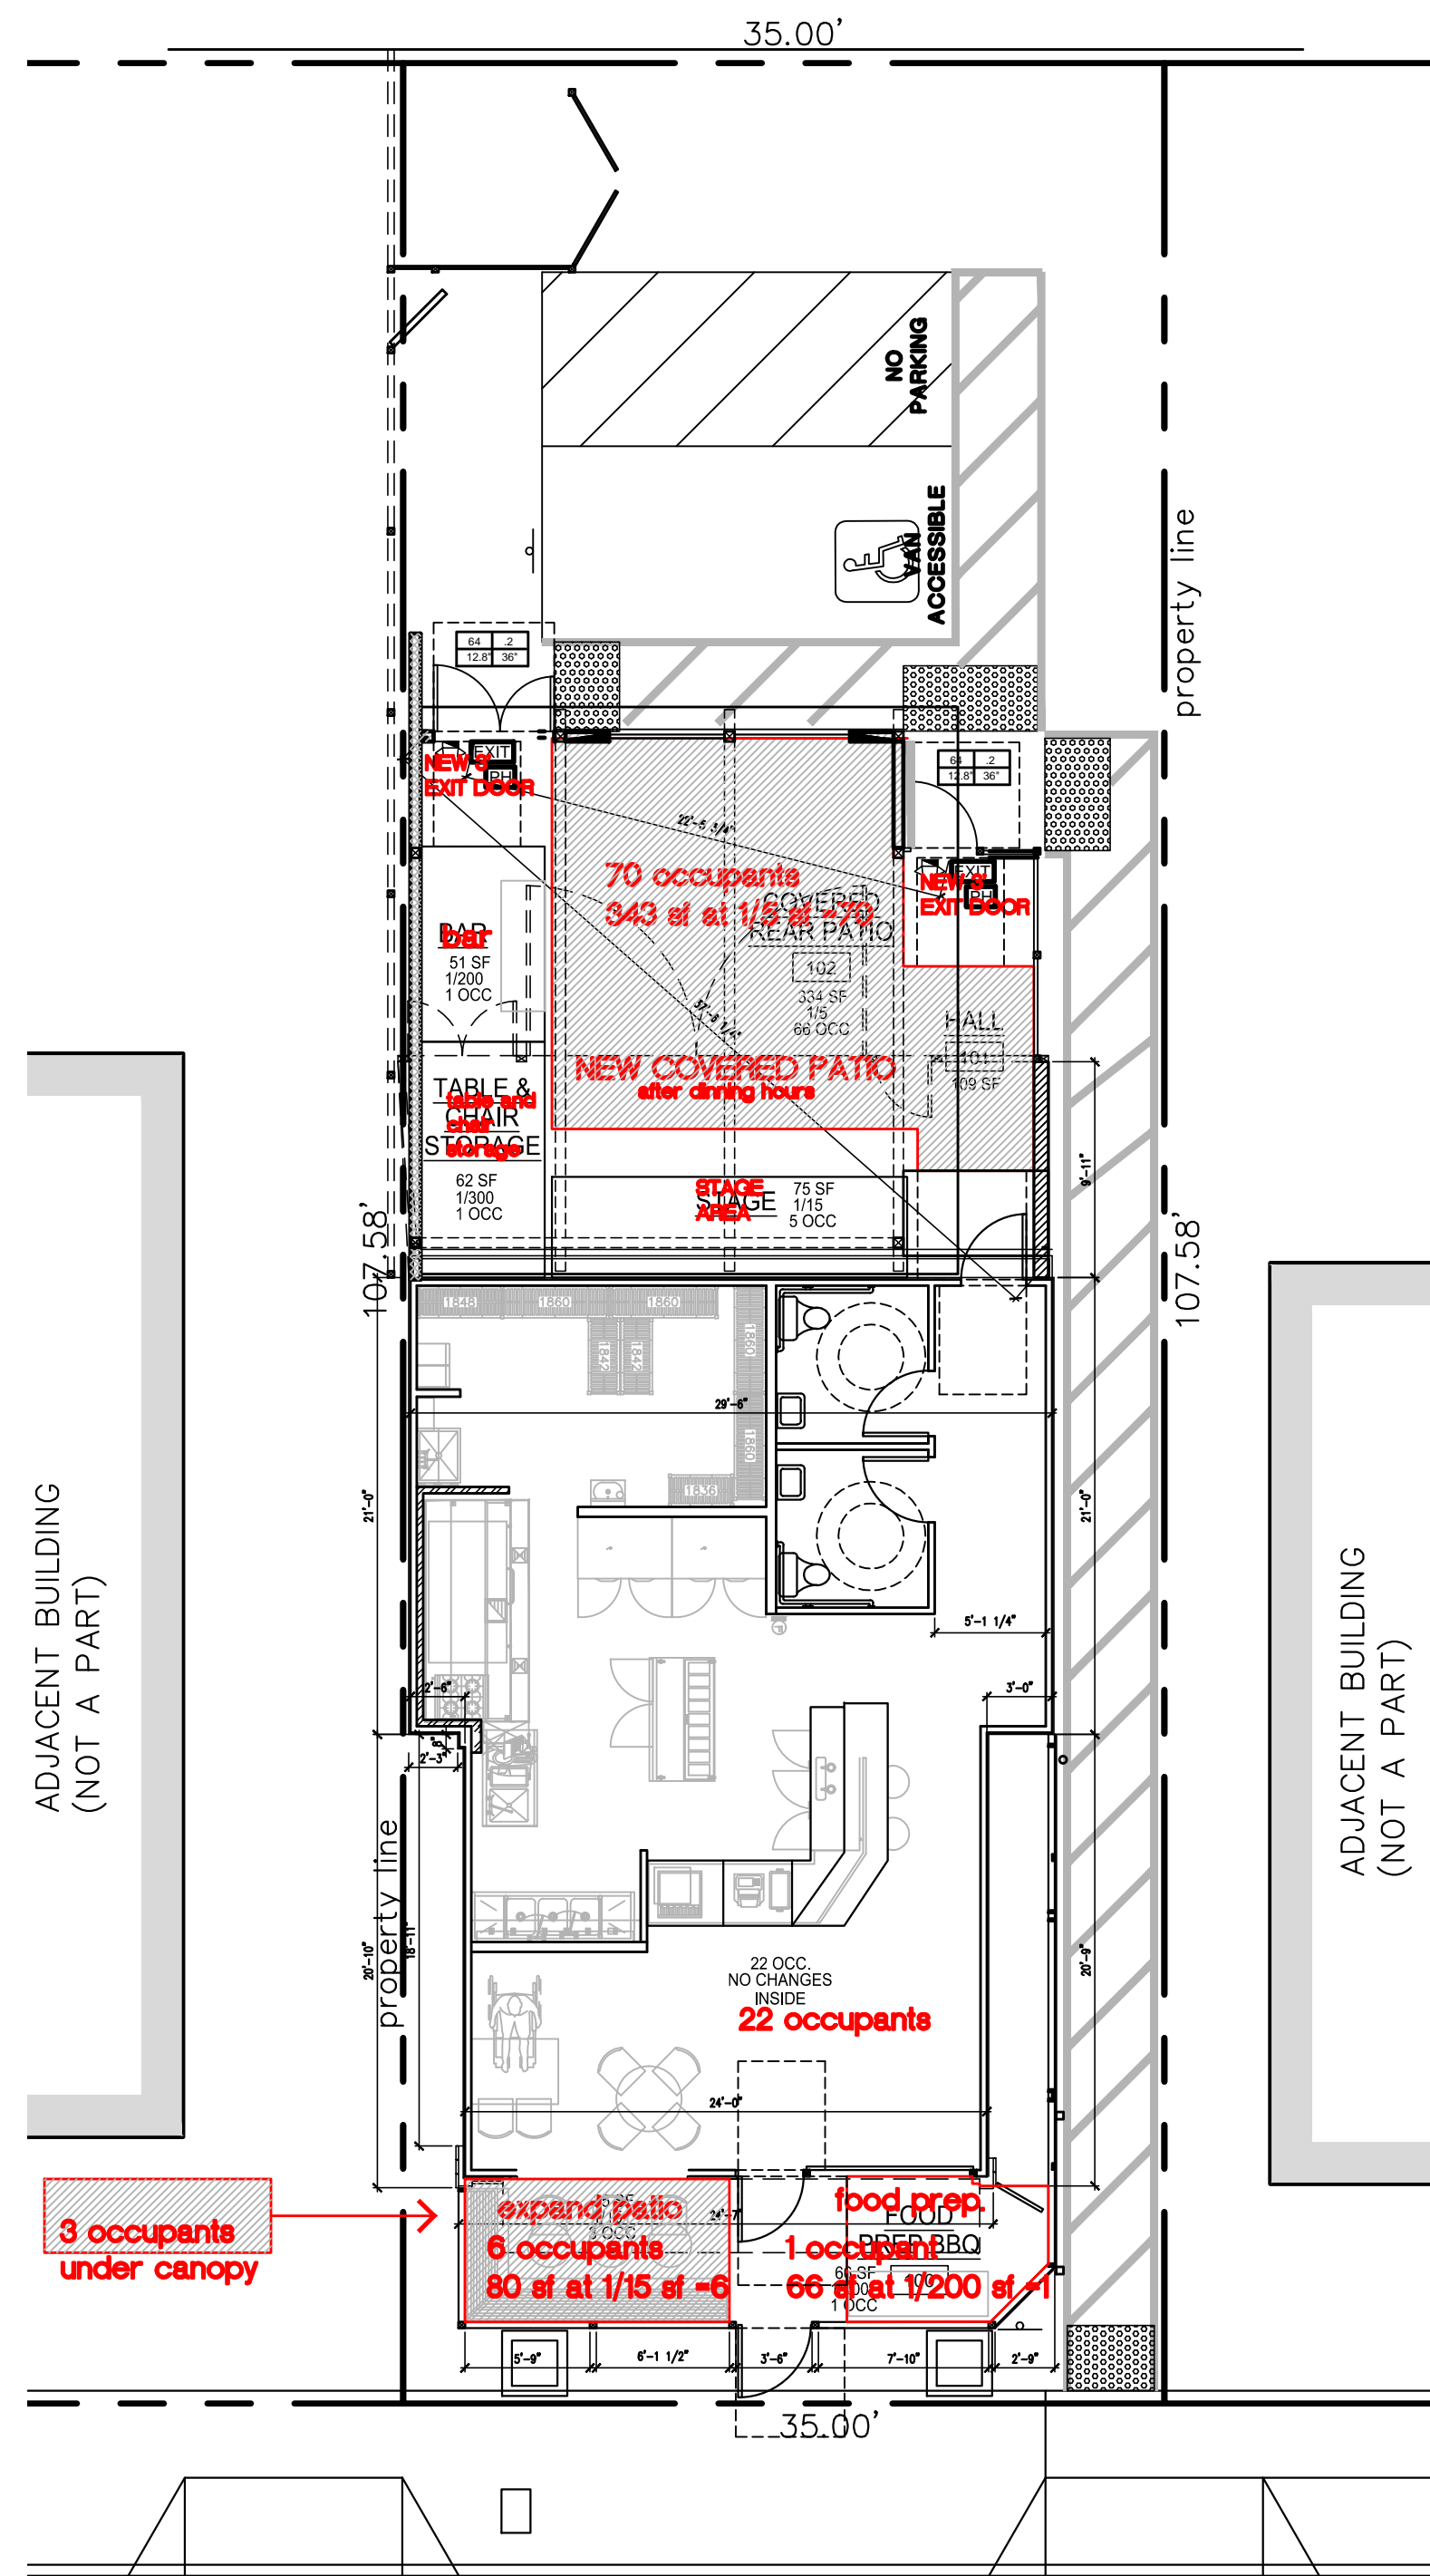

19th Street


EXIT AND OCCUPANCY PLAN (AFTER DINING)

SCALE: 1/8" = 1'-0"

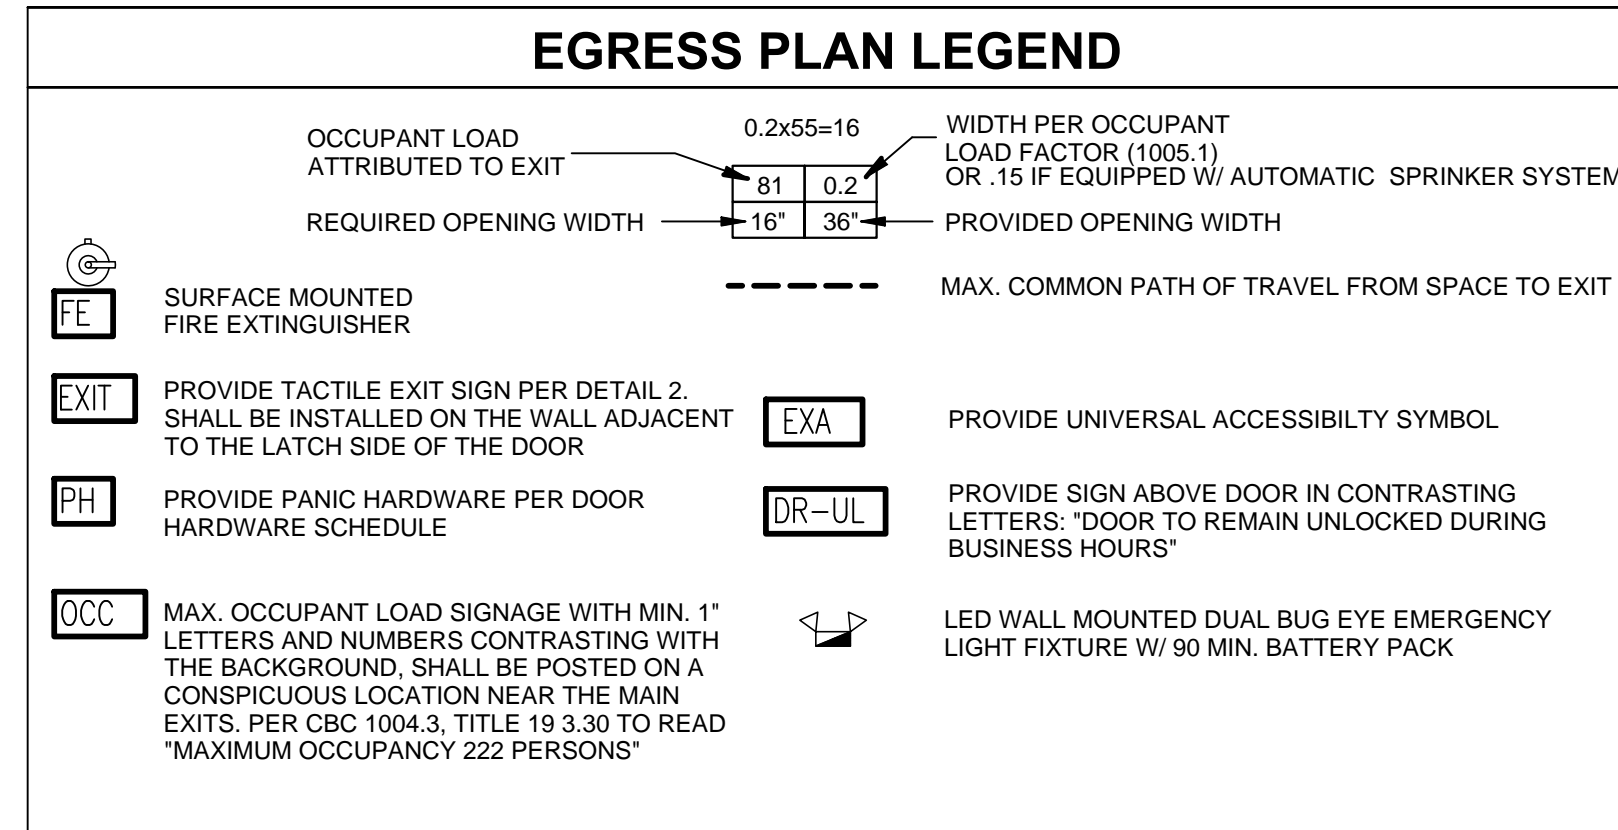


THE INTERNATIONAL SYMBOL OF ACCESSIBILITY SHALL BE THE STANDARD USED TO IDENTIFY FACILITIES THAT ARE ACCESSIBLE TO AND USABLE BY PHYSICALLY HANDICAPPED PERSONS. THE SYMBOL SHALL CONSIST OF A WHITE FIGURE ON A BLUE BACKGROUND. THE BLUE SHALL BE EQUAL TO COLOR #15090 IN FEDERAL STANDARD 595A.


ATTACH DECAL OF SYMBOL TO STOREFRONT IN LOCATIONS AS SHOWN ON PLAN. MOUNT 60" A.F.F.

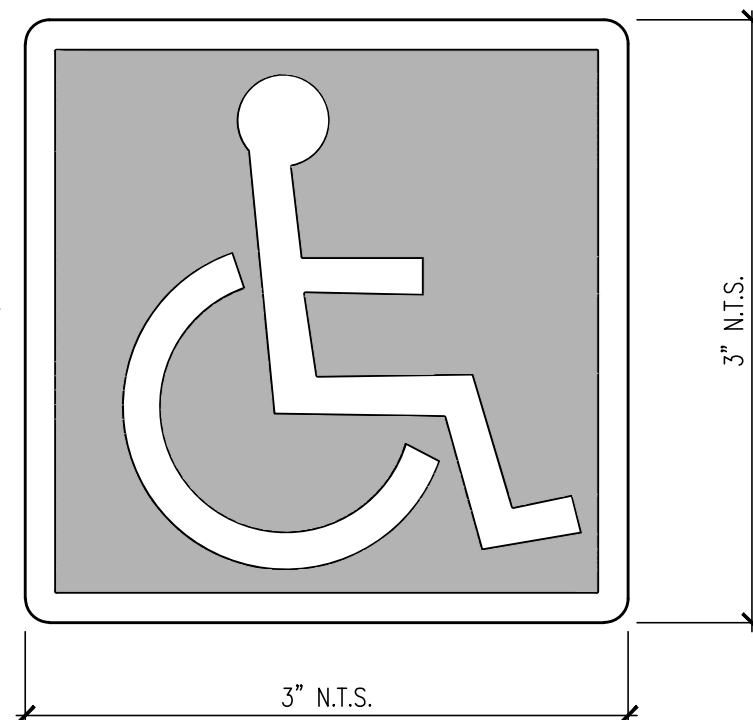

INTERNATIONAL ACCESSIBILITY SIGN  
SCALE: N.T.S. SYMBOL EXA

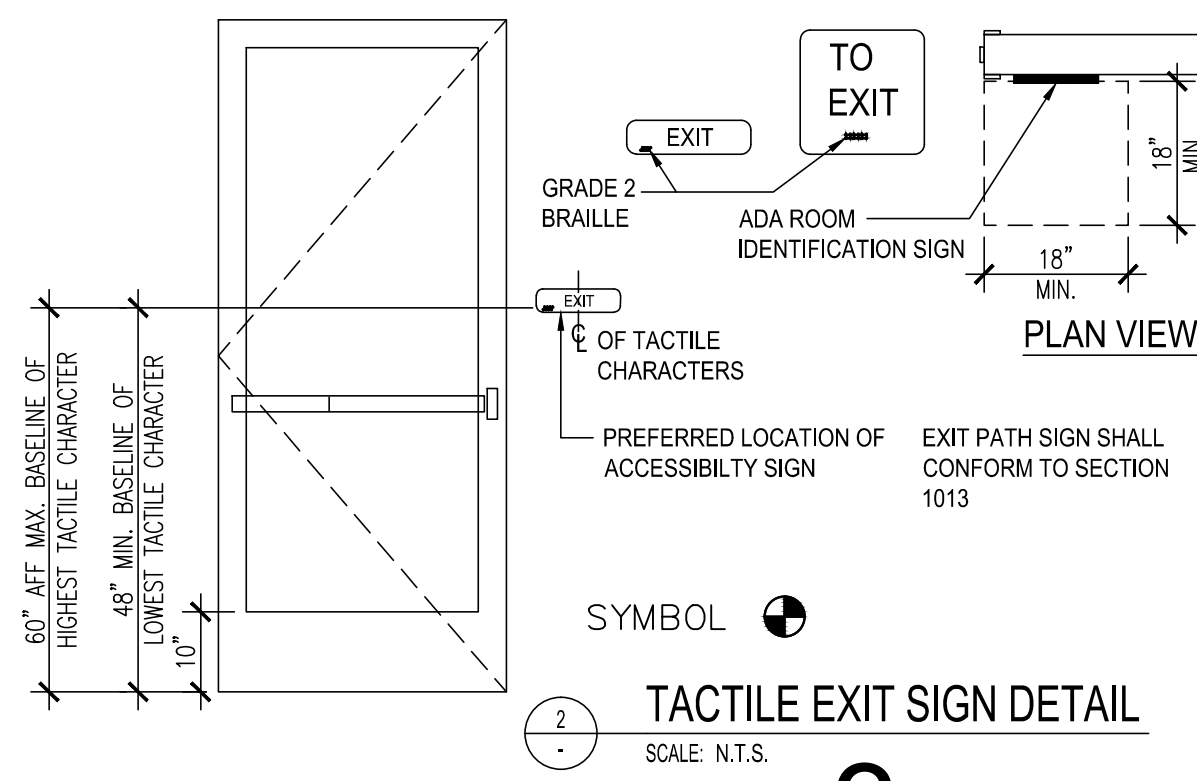


TACTILE EXIT SIGN DETAIL  
SCALE: N.T.S.

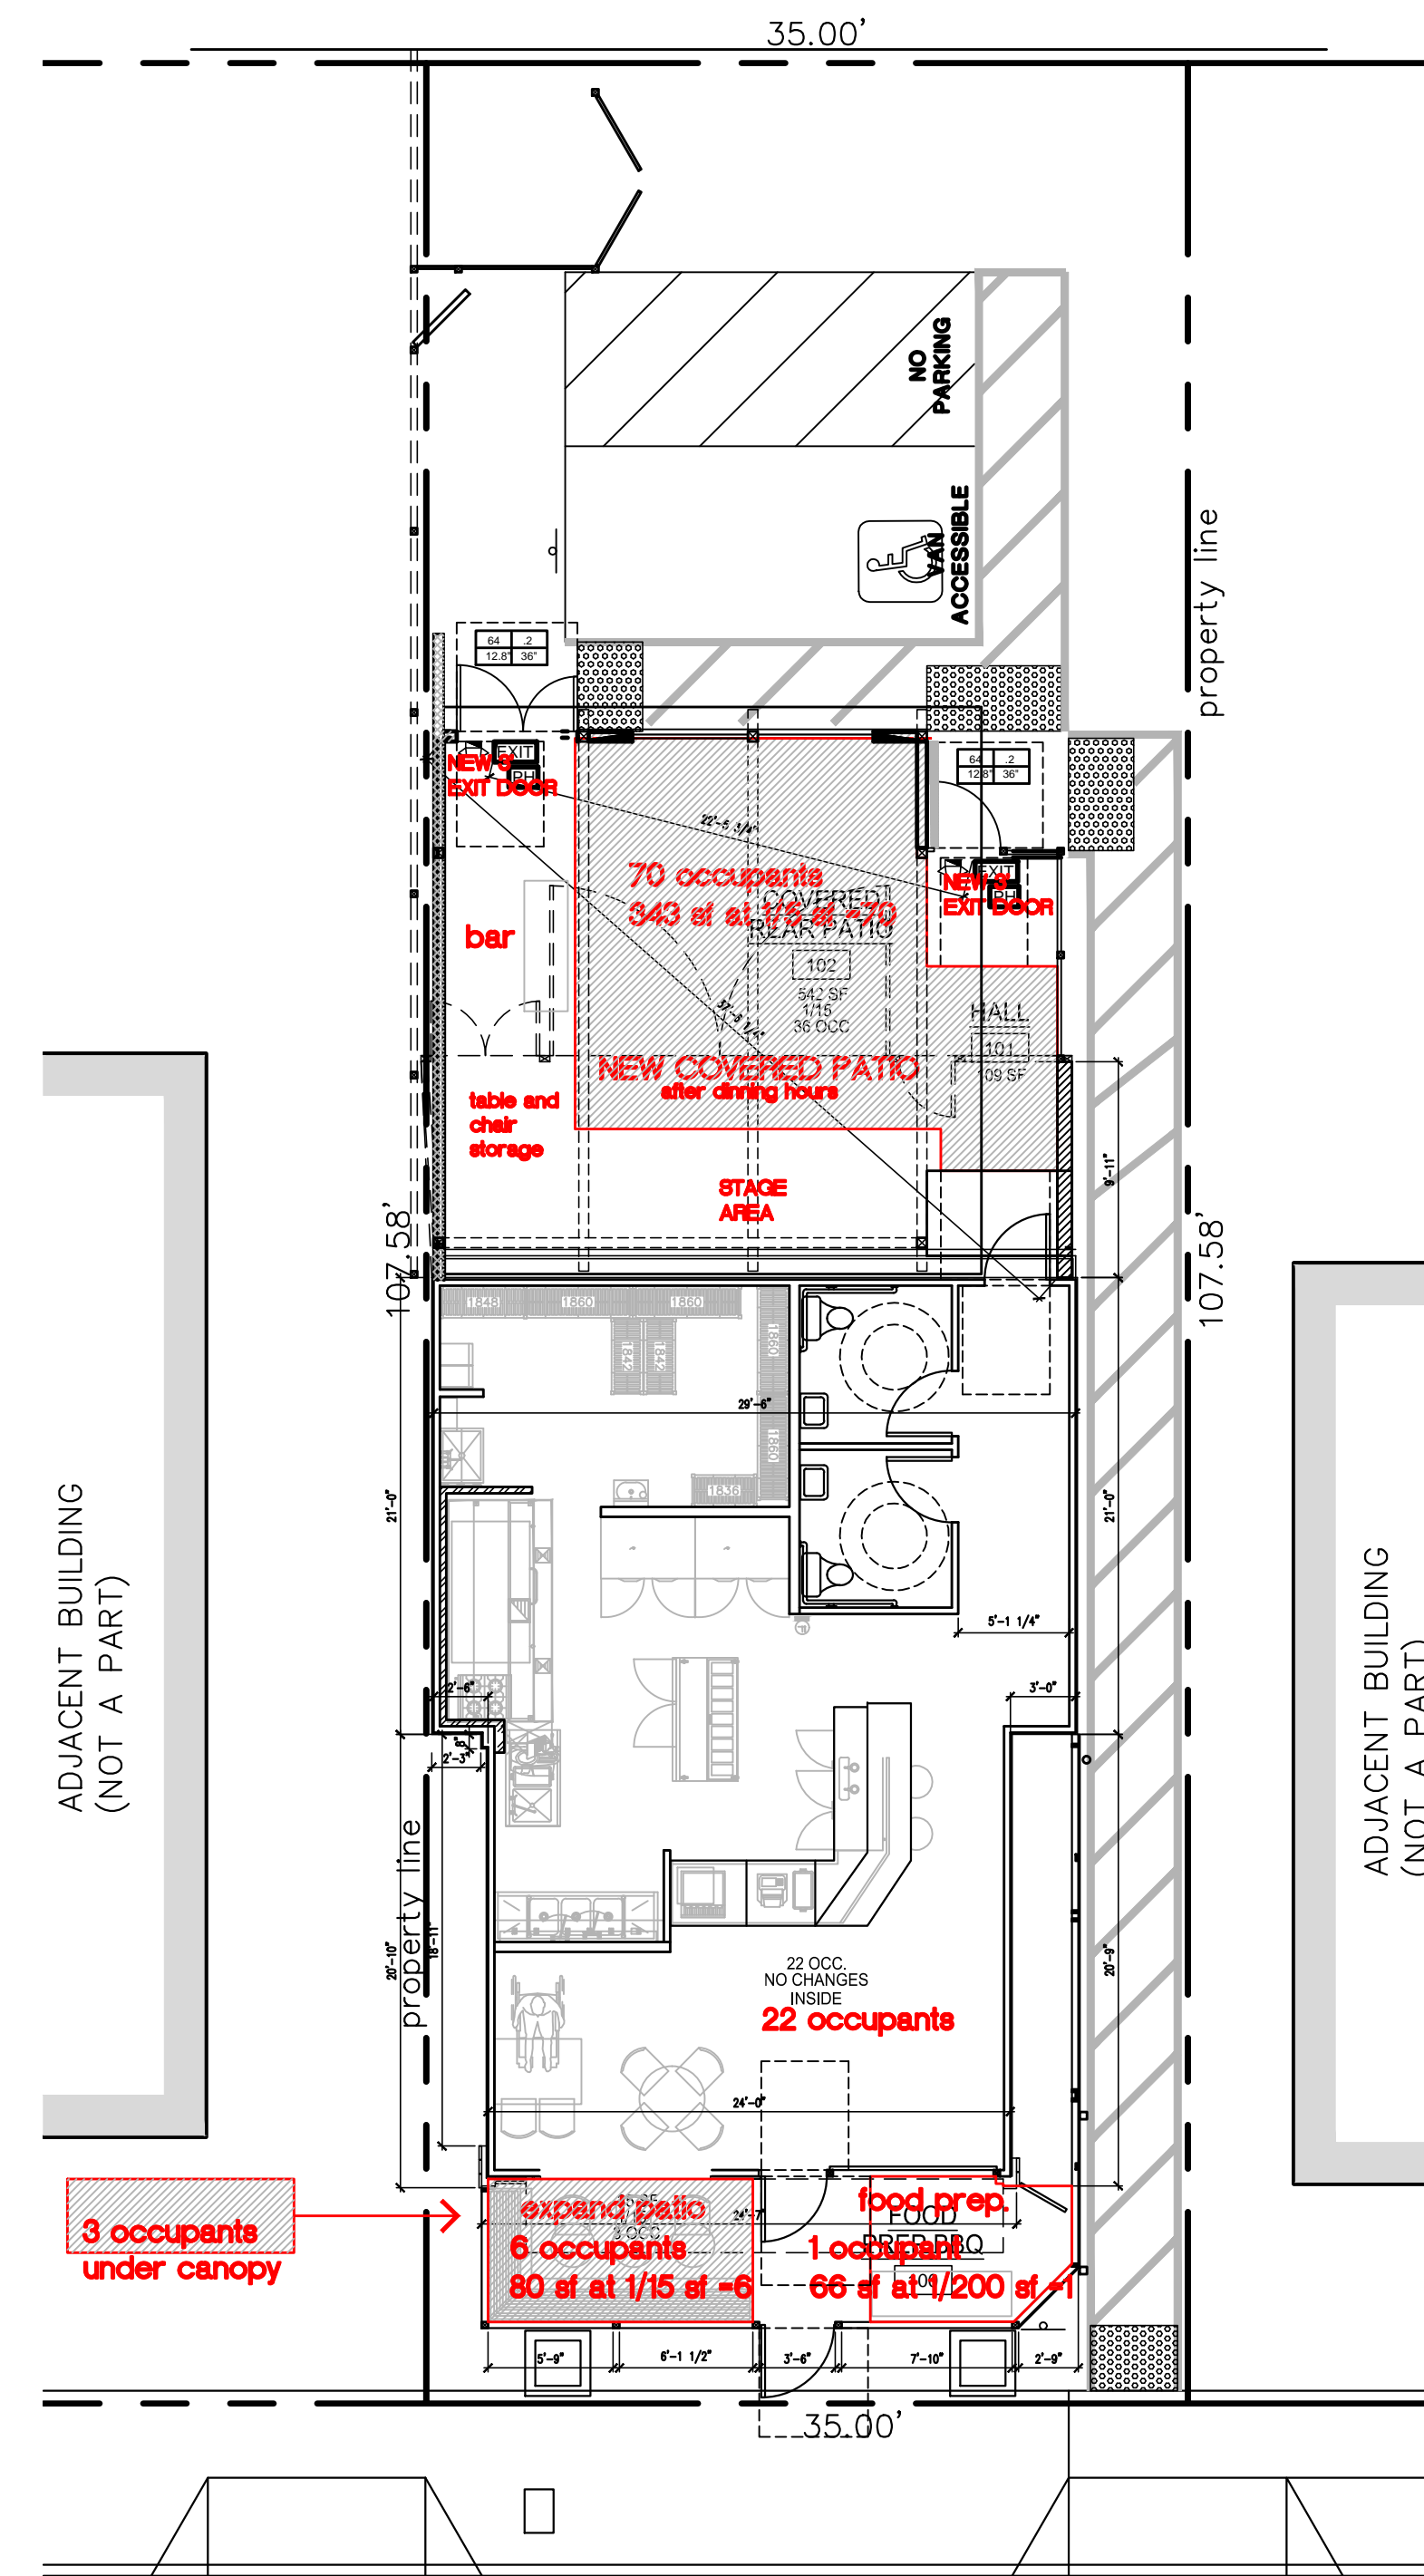

19th Street

EXIT AND OCCUPANCY PLAN (DINING HOURS)

SCALE: 1/8" = 1'-0"

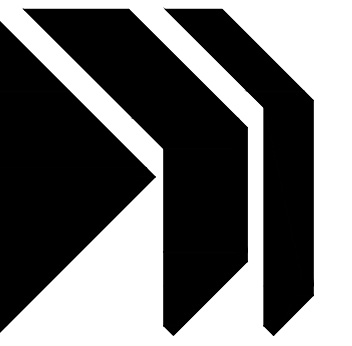

J.C. MARVICK & ASSOC., INC.  
ARCHITECTURE / PLANNING  
1827 Capital Street, suite 101  
Corona, Calif. 92789 951-808-0520



Drawings and Specifications as instruments of service are and shall remain the property of the Architect. The Drawings and Specifications shall not be used on other projects. For additions to this project by others except by agreement in writing with the Architect. Any use or reproduction of this drawing in whole or part by any means is strictly prohibited except with specific written consent of John C. Marvick, Architect.

© COPYRIGHT 2023, JOHN C. MARVICK, ARCHITECT

# Westend Restaurant

SITE IMPROVEMENT  
814 WEST 19TH STREET  
COSTA MESA, CA 92627

ISSUE RECORD:  
6-1-23 C.U.P. SUBMITTAL

DRAWN: C.M. CHECKED: C.M.

PROJECT NUMBER:  
22-13 WEST END RESTAURANT

SHEET TITLE:  
EXIT AND OCCUPANCY PLAN

SHEET NUMBER:

A-0.1


DATE OF LAST PRINT: 5-16-23











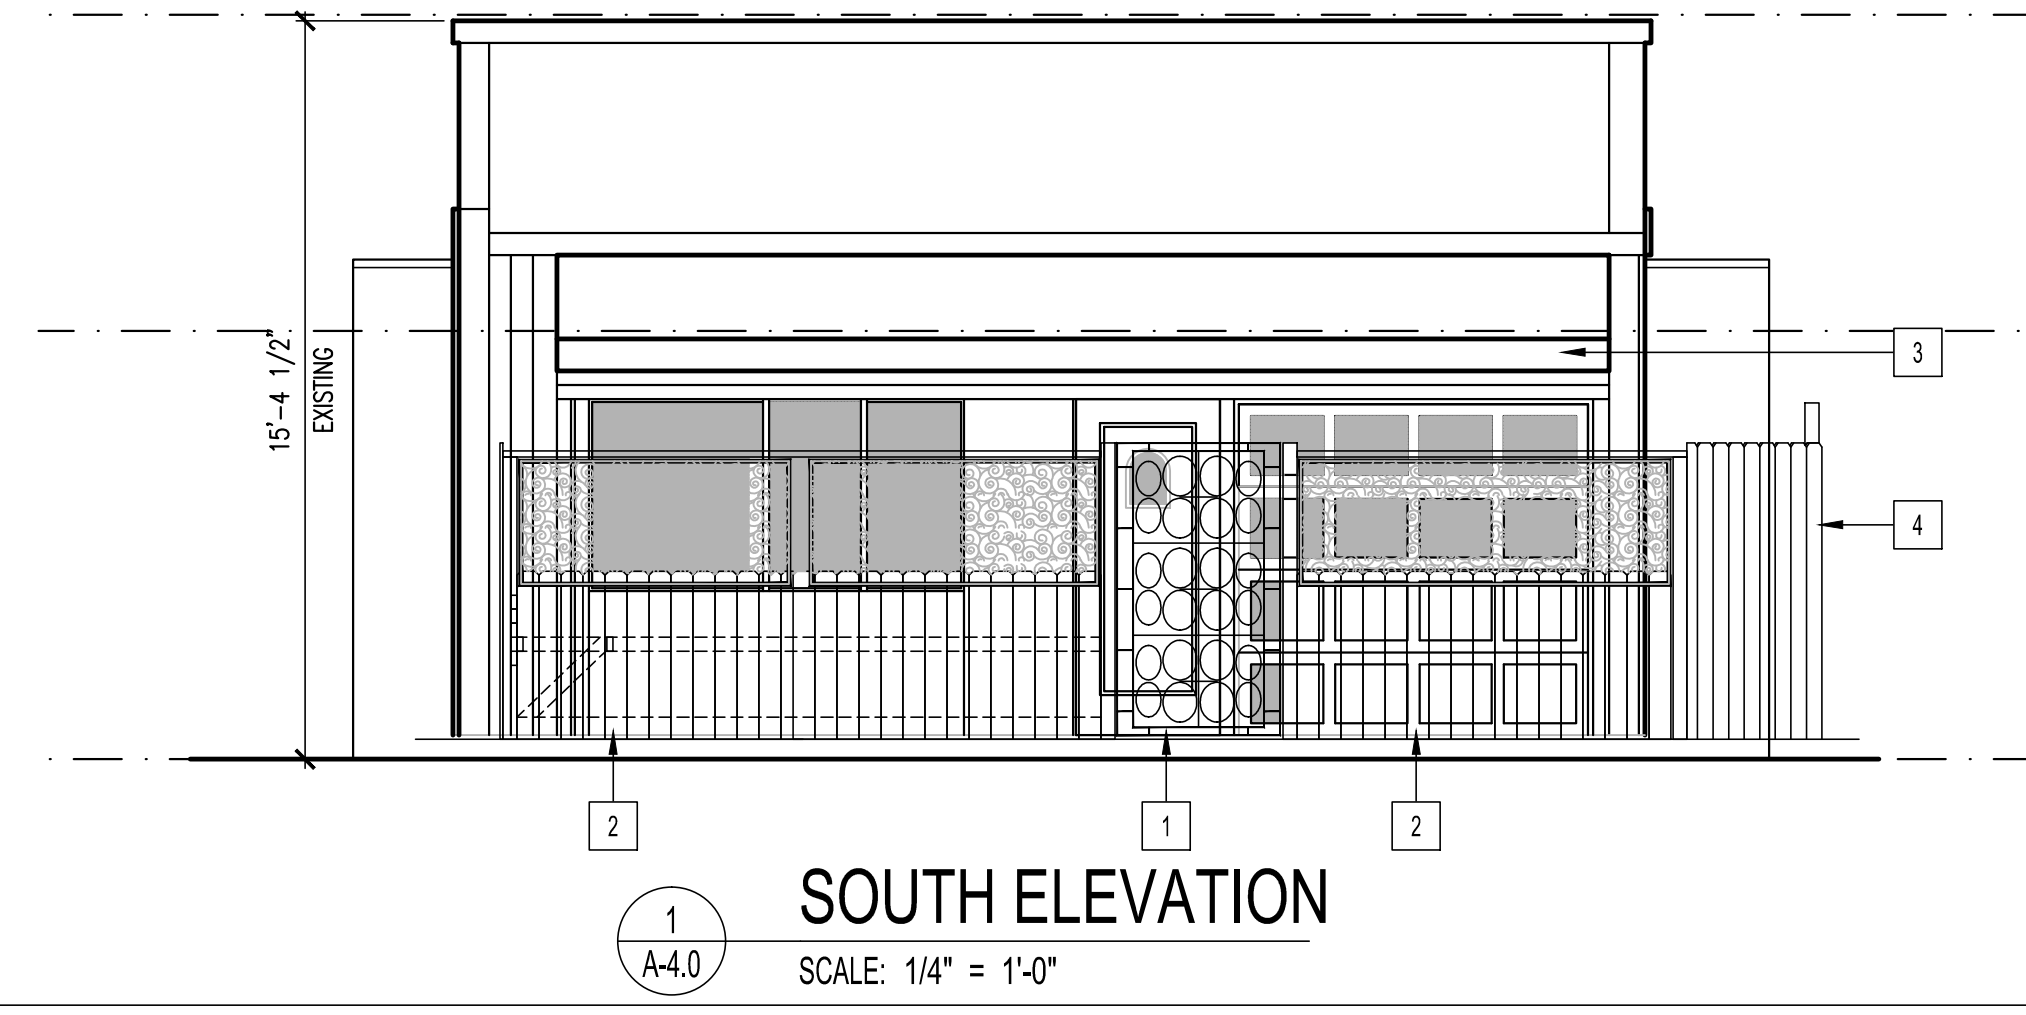


**SOUTH ELEVATION**  
 1  
 A-4.0  
 SCALE: 1/4" = 1'-0"

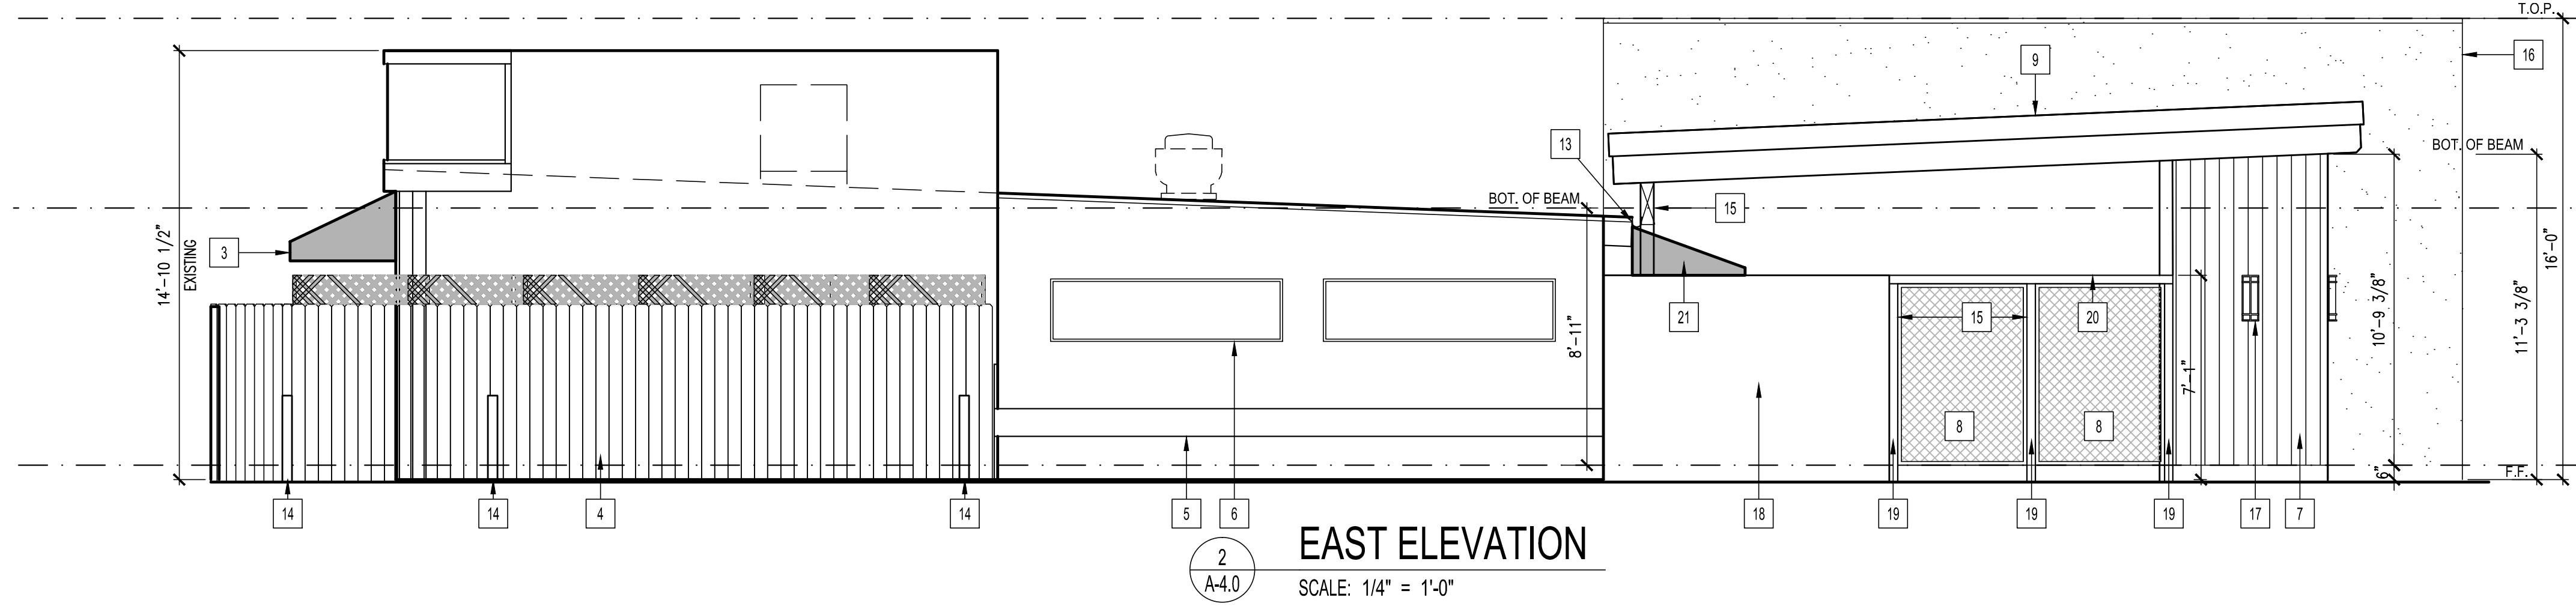

**EAST ELEVATION**  
 2  
 A-4.0  
 SCALE: 1/4" = 1'-0"

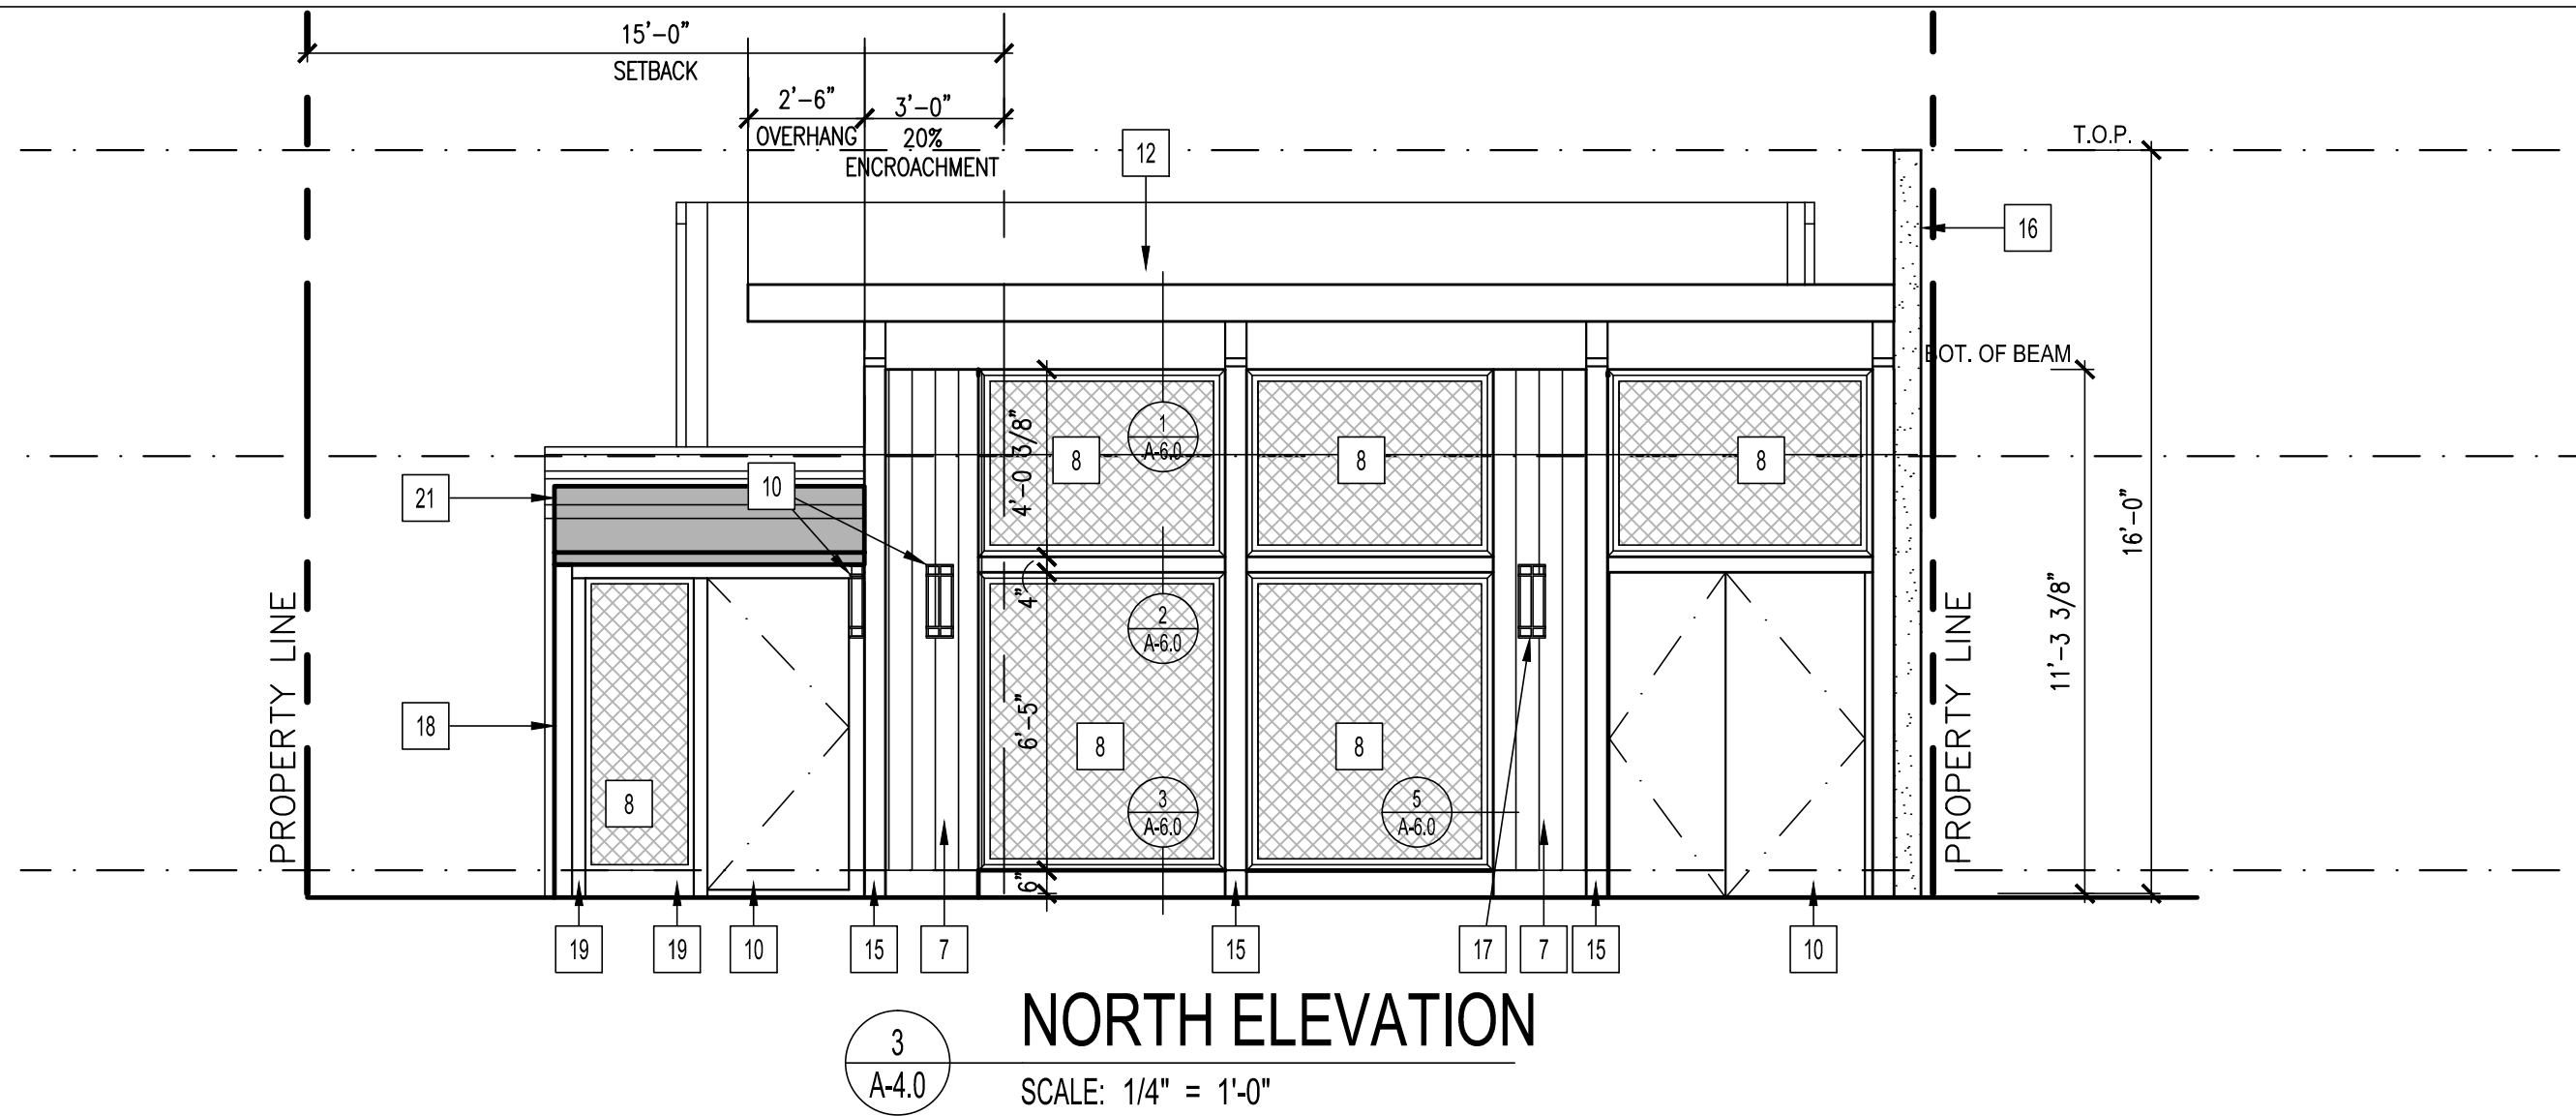

**NORTH ELEVATION**  
 3  
 A-4.0  
 SCALE: 1/4" = 1'-0"

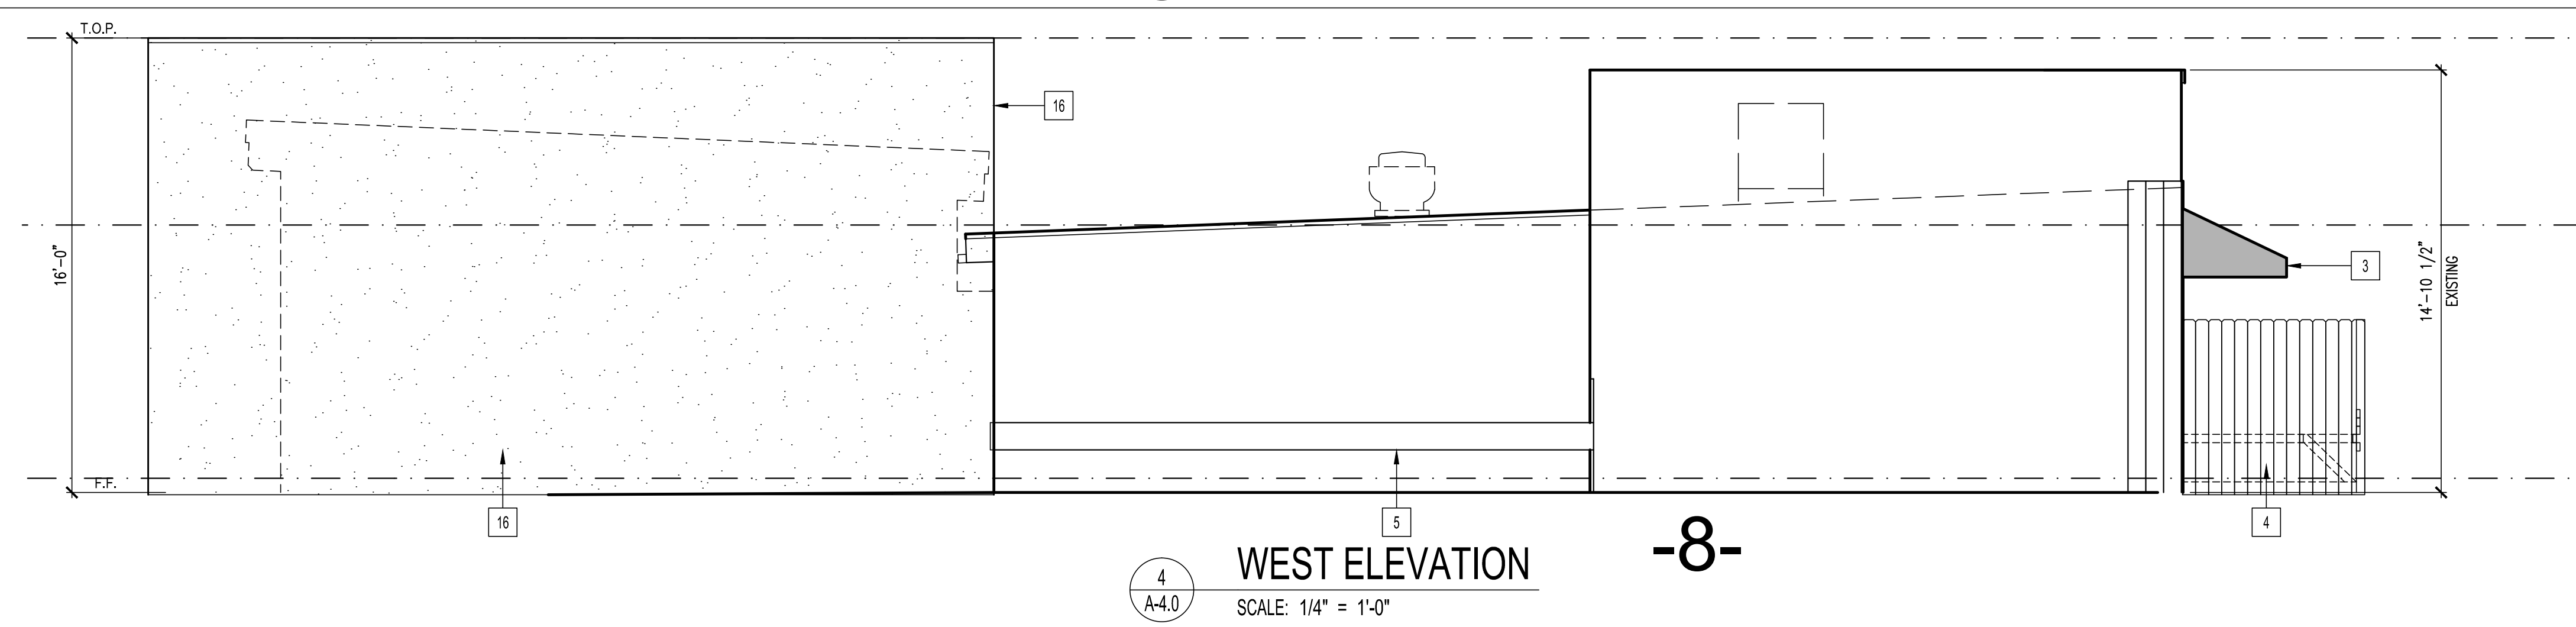


**WEST ELEVATION**  
 4  
 A-4.0  
 SCALE: 1/4" = 1'-0"

**-8-**

**KEY NOTES**

- 1 (E) WROUGHT IRON ENTRY GATE
- 2 (E) 42' HIGH WOOD FENCE W/ WROUGHT IRON ABOVE
- 3 (E) FABRIC AWNING
- 4 (E) 6' HIGH WOOD FENCE
- 5 (E) 2x12 WOOD TRIM
- 6 (E) WINDOWS
- 7 (N) 1x6 WOOD SIDING PER PLAN
- 8 (N) METAL MESH PANEL
- 9 (N) TPO ROOFING
- 10 (N) REAR DOOR PER DOOR SCHEDULE
- 11 (E) REAR WOOD GATES
- 12 (N) WOOD FRAMED PATIO COVER - SEE FRAMING PLAN
- 13 (E) REAR FASCIA AND RAIN GUTTER
- 14 (E) BOLLARDS TO REMAIN - TYP.
- 15 (N) 2x POST PER PLAN
- 16 (N) STUCCO WALL PER PLAN
- 17 (N) WALL SCONCE MOUNT AT 5'-6" A.F.F. TO BOTTOM OF FIXTURE - SEE ELECTRICAL DRAWINGS
- 18 (E) CMU WALL TO REMAIN
- 19 (N) 4x4 POST PER PLAN
- 20 (N) 4x4 HEADER PER PLAN
- 21 (N) CANVAS AWNING AT REAR DOOR

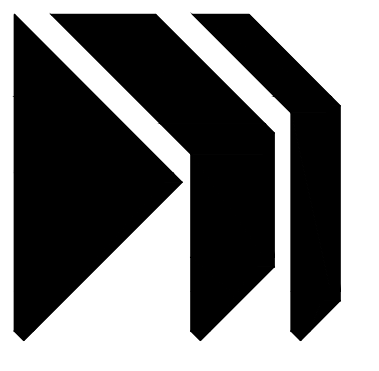

**J.C. MARVICK & ASSOC., INC.**  
 ARCHITECTURE / PLANNING  
 1827 Capital Street, suite 101  
 Corona, Calif. 92878 951-808-0520



Drawings and Specifications as instruments of service are and shall remain the property of the Architect. The Drawings and Specifications shall not be used on other projects. For additions to this project by others except by agreement in writing with the Architect. Any use or reproduction of this drawing in whole or part by any means is strictly prohibited except with specific written consent of John C. Marvick, Architect.  
 © COPYRIGHT 2023, JOHN C. MARVICK, ARCHITECT

**Westend Restaurant**  
 SITE IMPROVEMENT  
 814 WEST 19TH STREET  
 COSTA MESA, CA 92627

ISSUE RECORD:	
6-1-23	C.U.P. SUBMITTAL

DRAWN:	CHECKED:
C.M.	C.M.


PROJECT NUMBER:  
 22-13 WEST END RESTAURANT

SHEET TITLE:  
 ELEVATIONS

SHEET NUMBER:  
 A-5.0

DATE OF LAST PRINT:  
 5-16-23




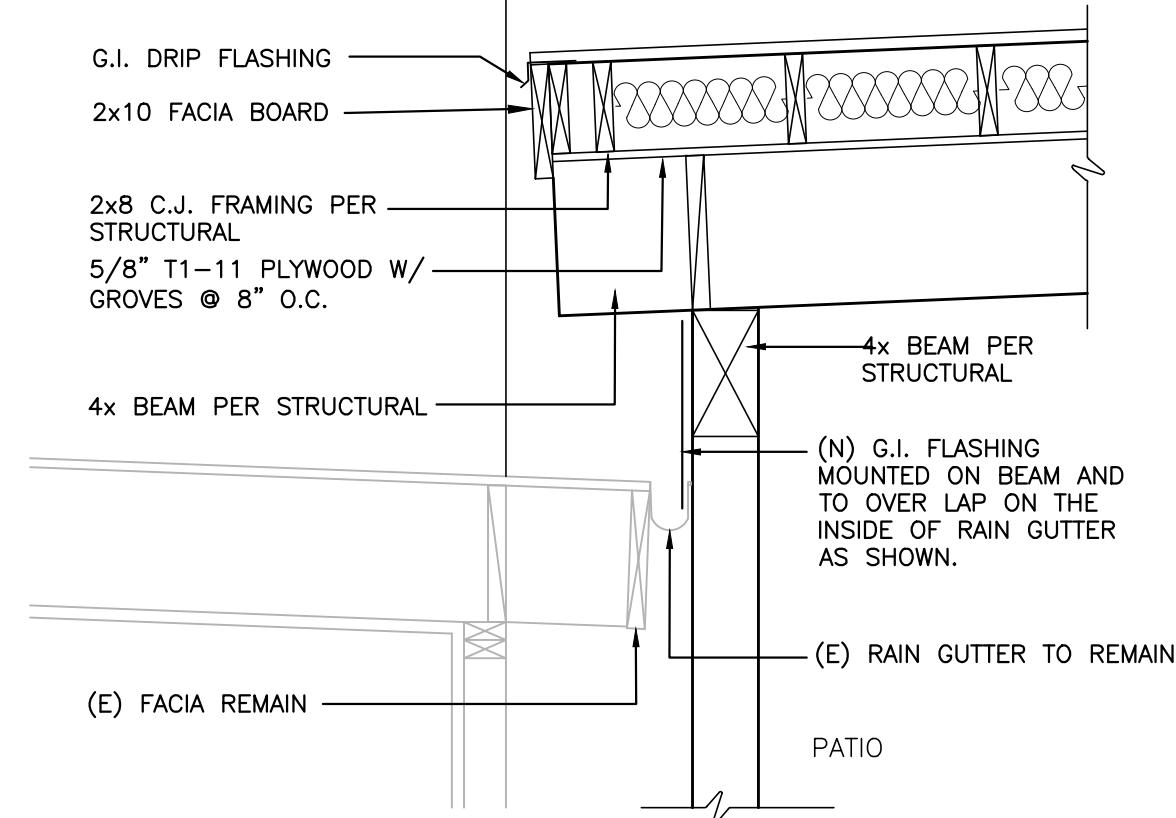

**FACIA AT FRONT**

SCALE: 3/4" = 1'-0"


4

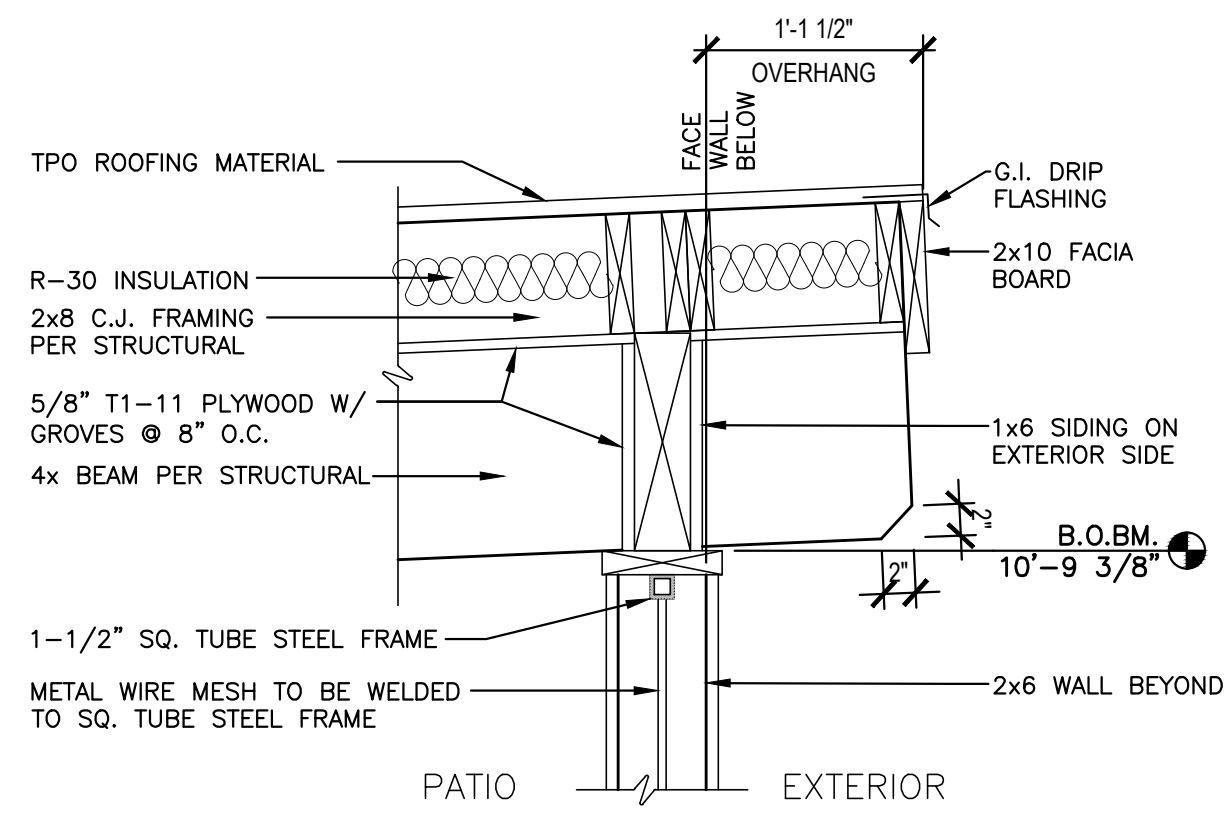

**FACIA AT REAR**

SCALE: 1" = 1'-0"


1

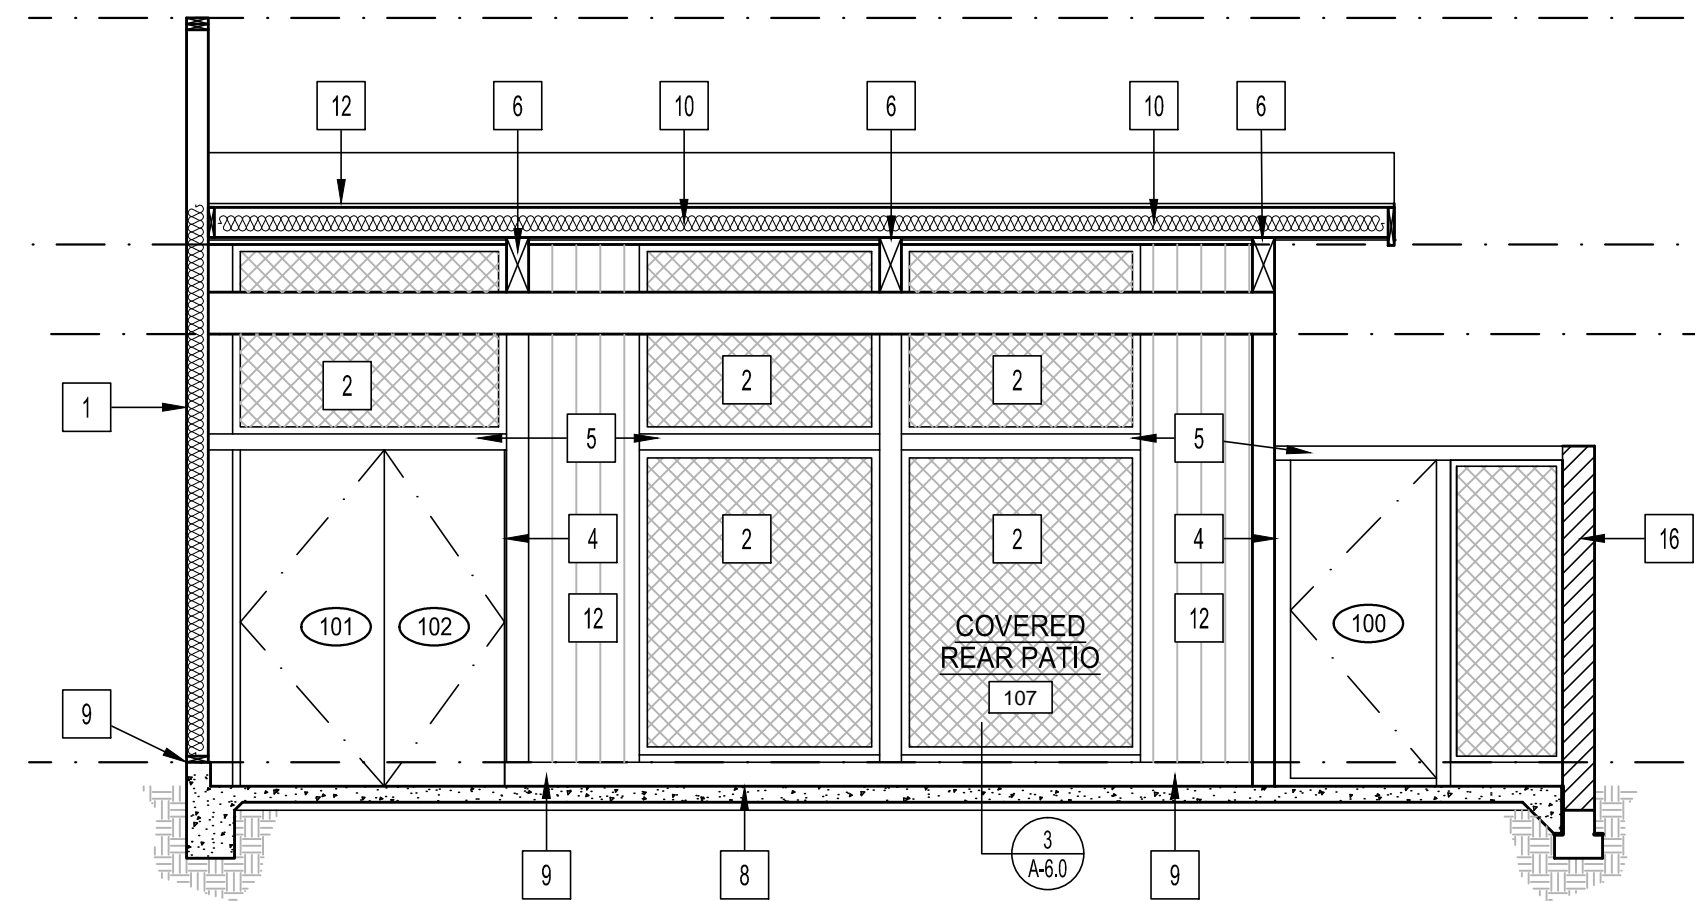

**SECTION 1**

SCALE: 1/4" = 1'-0"


1

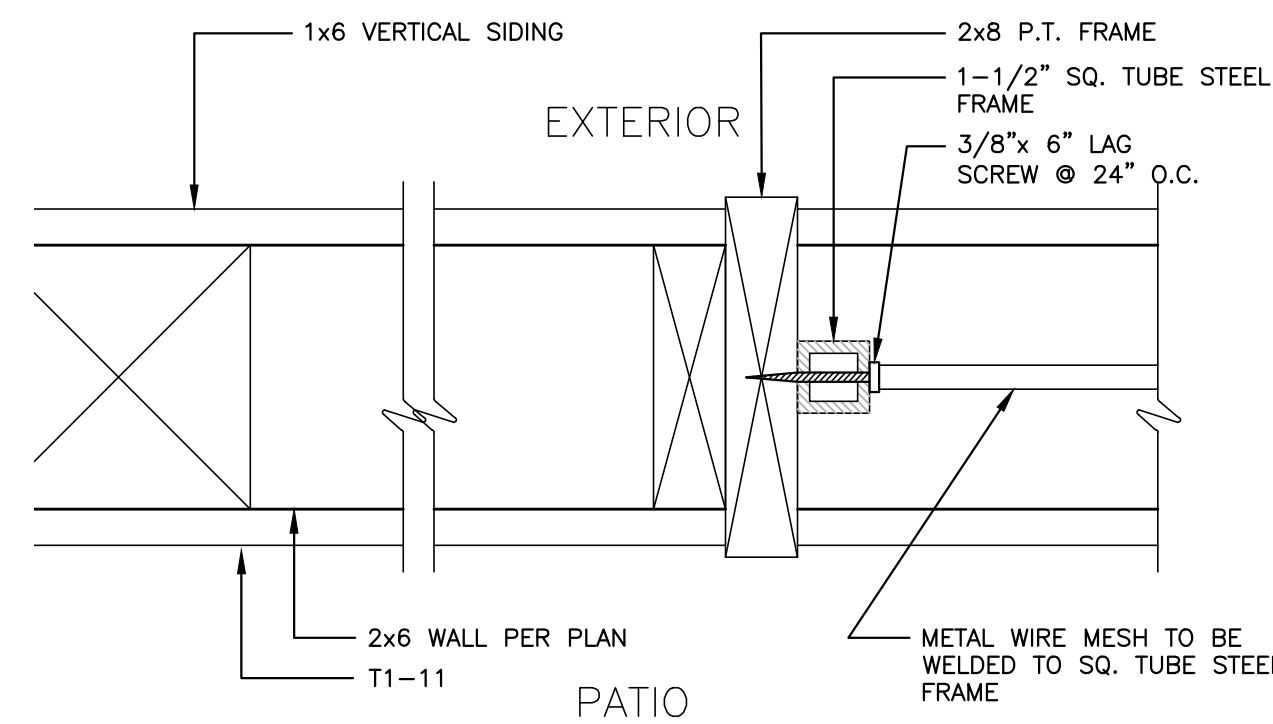

**MESH PANEL TO WALL**

SCALE: 1" = 1'-0"


5

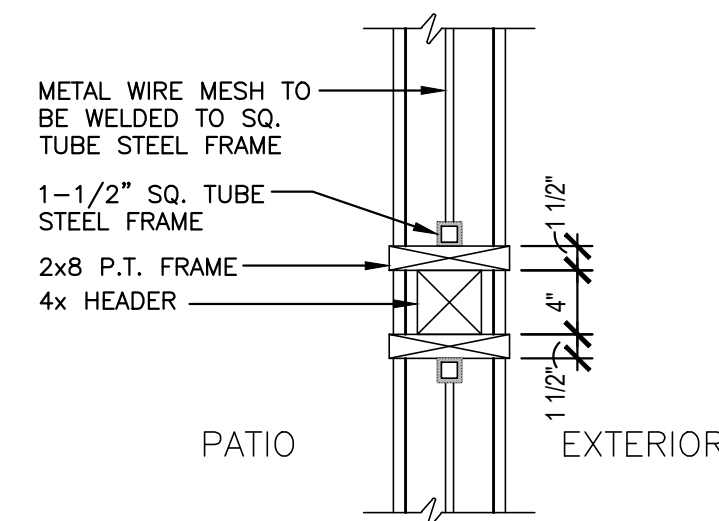

**HEADER AT MESH PANEL**

SCALE: 1" = 1'-0"


2

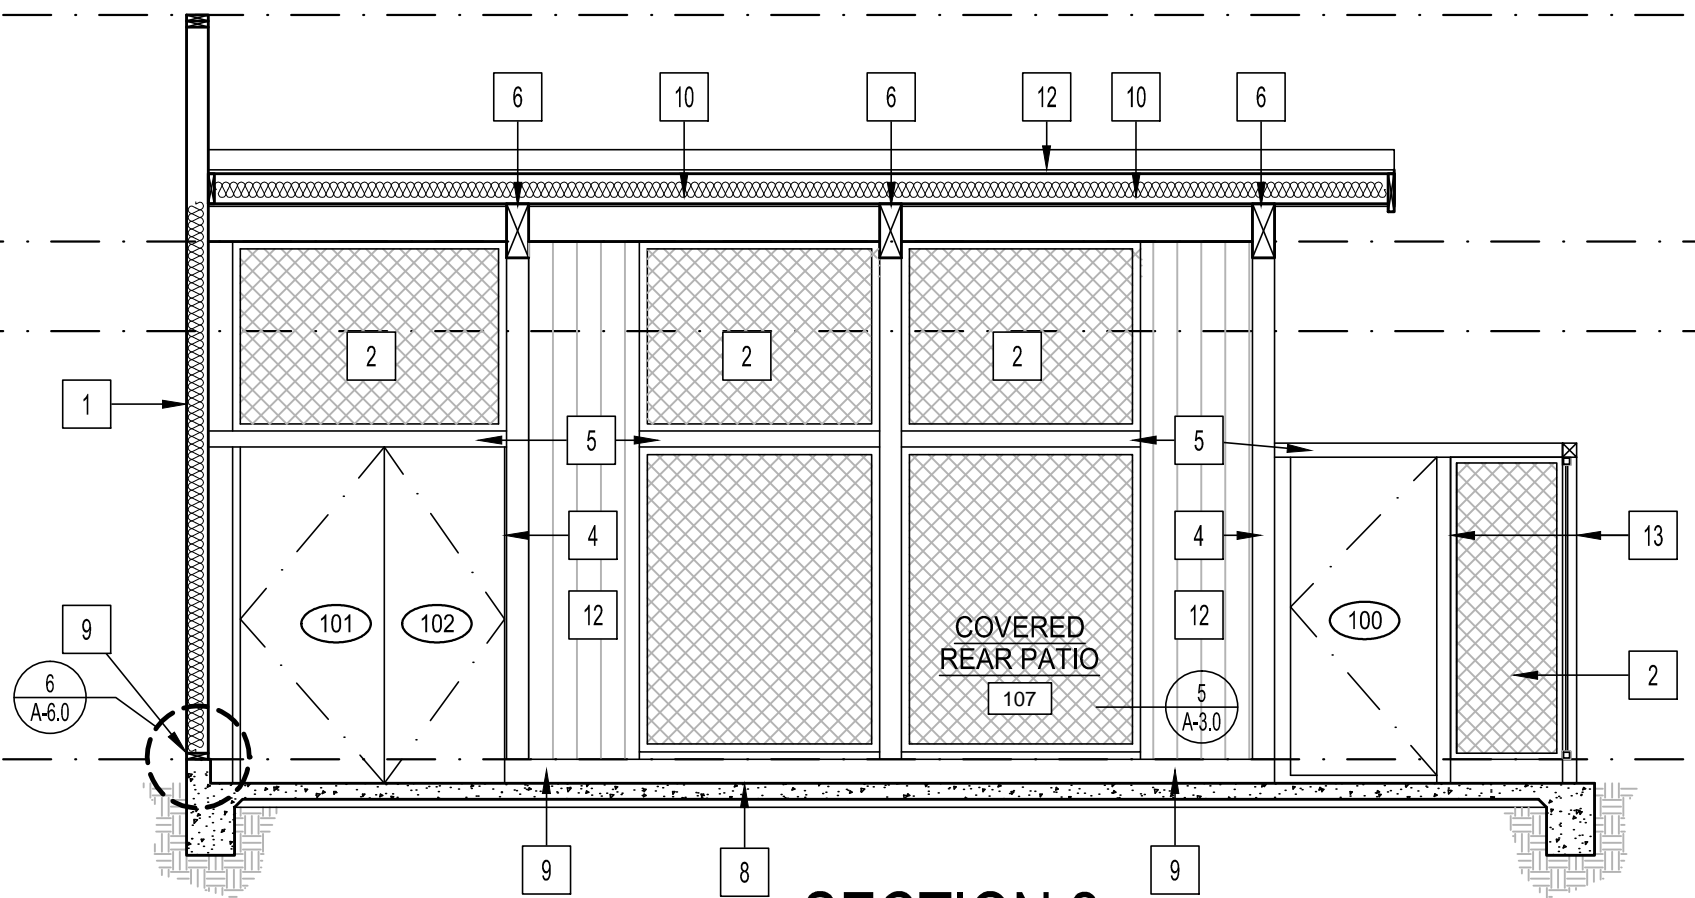

**SECTION 2**

SCALE: 1/4" = 1'-0"


2

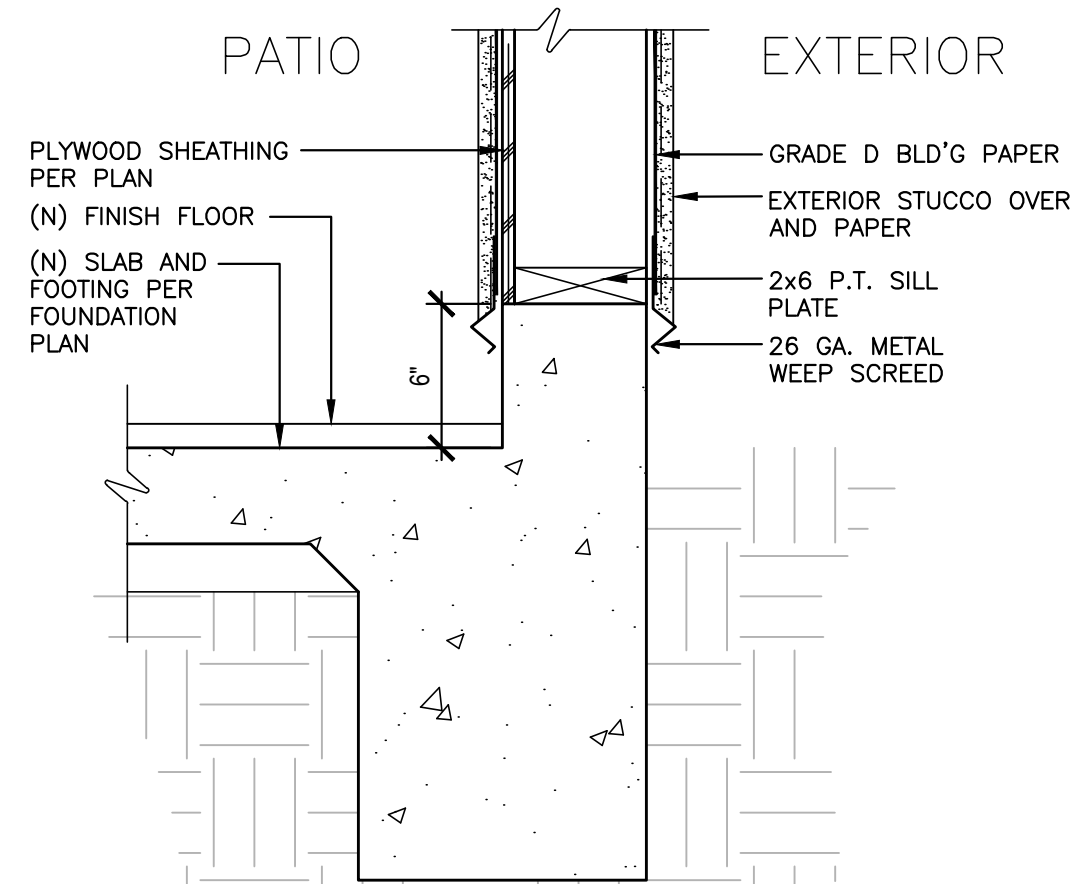

**SCREED @ STUCCO WALL**

SCALE: 1" = 1'-0"


6

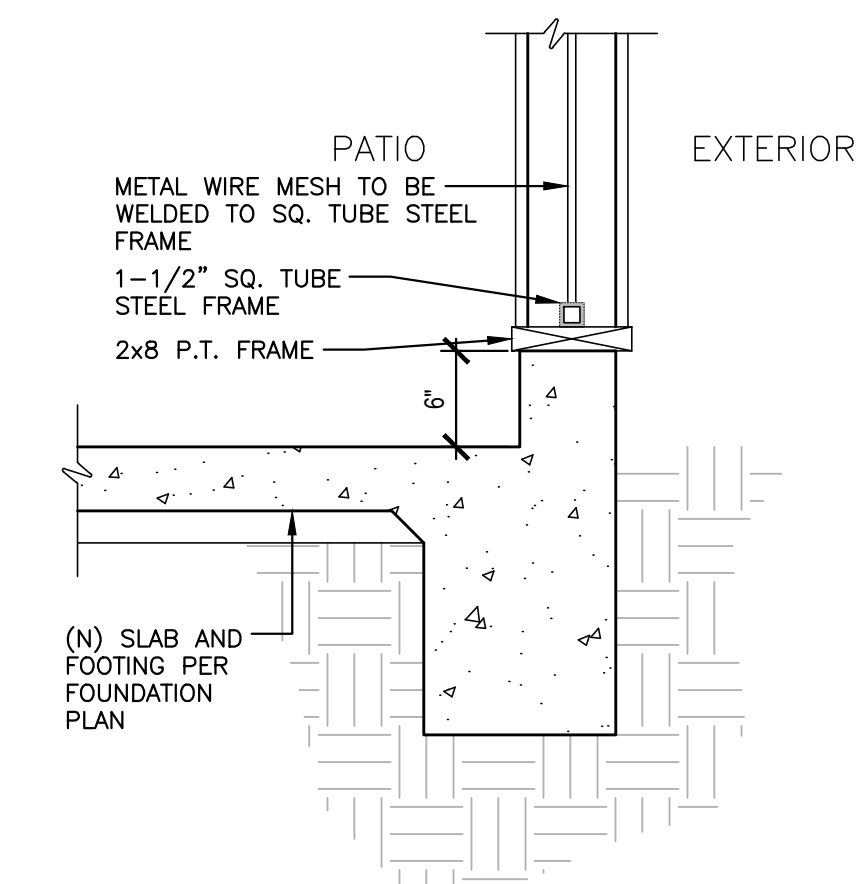

**MESH PANEL AT CURB**

SCALE: 1" = 1'-0"


3

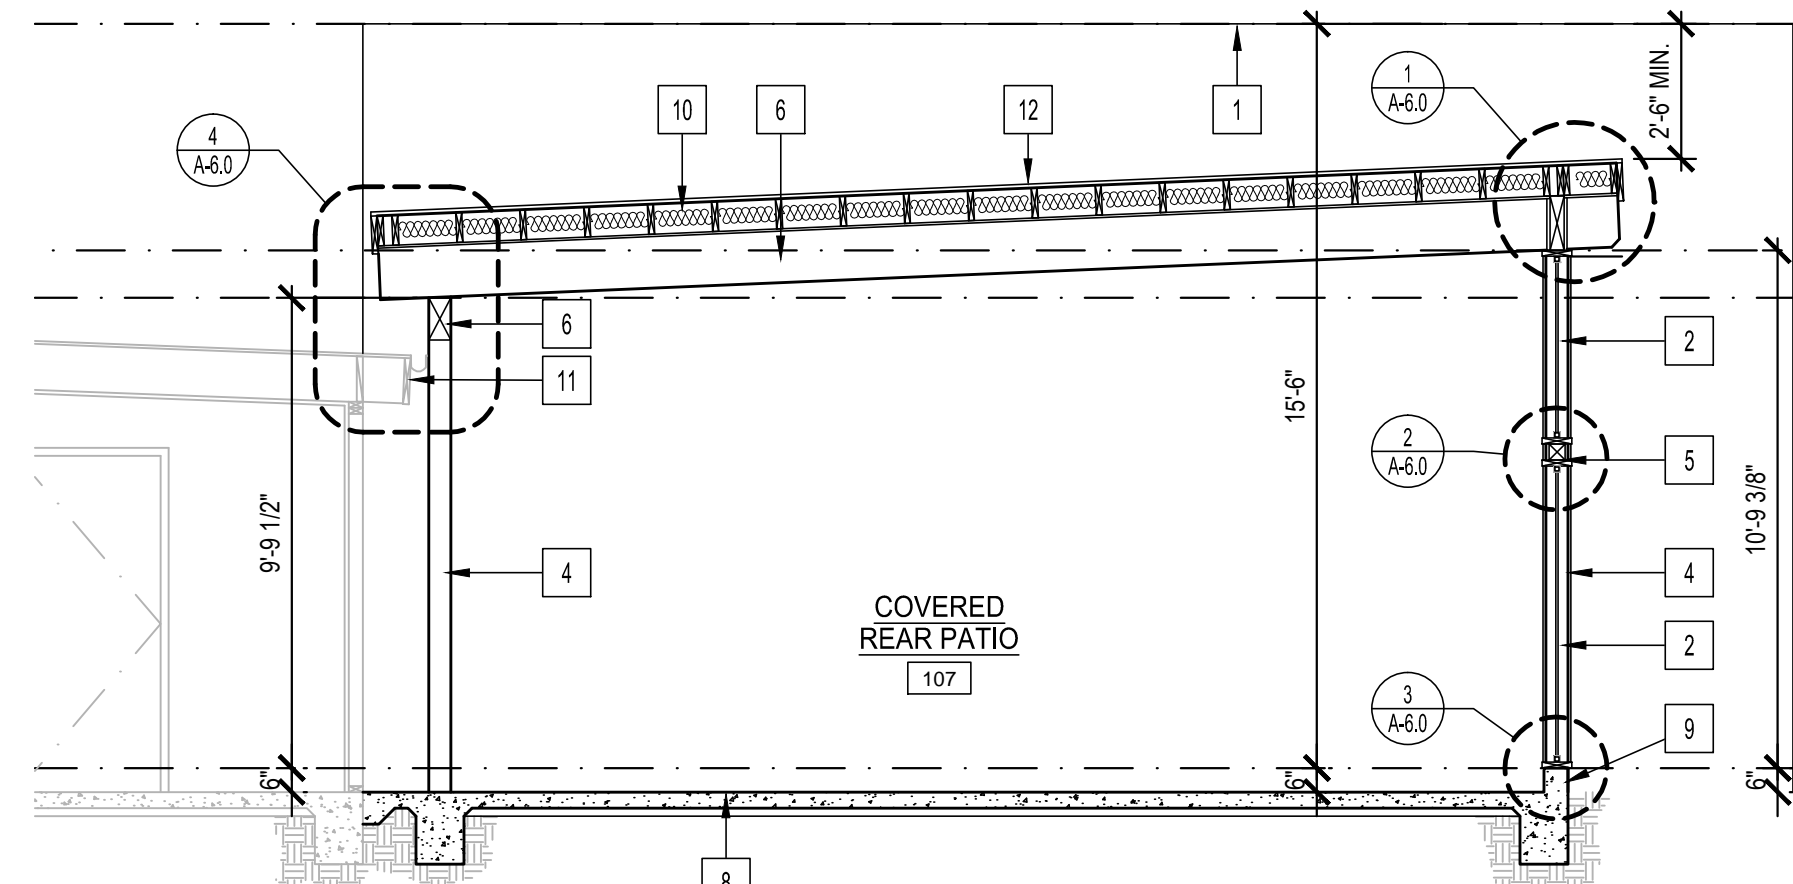

**SECTION 3**

SCALE: 1/4" = 1'-0"

3

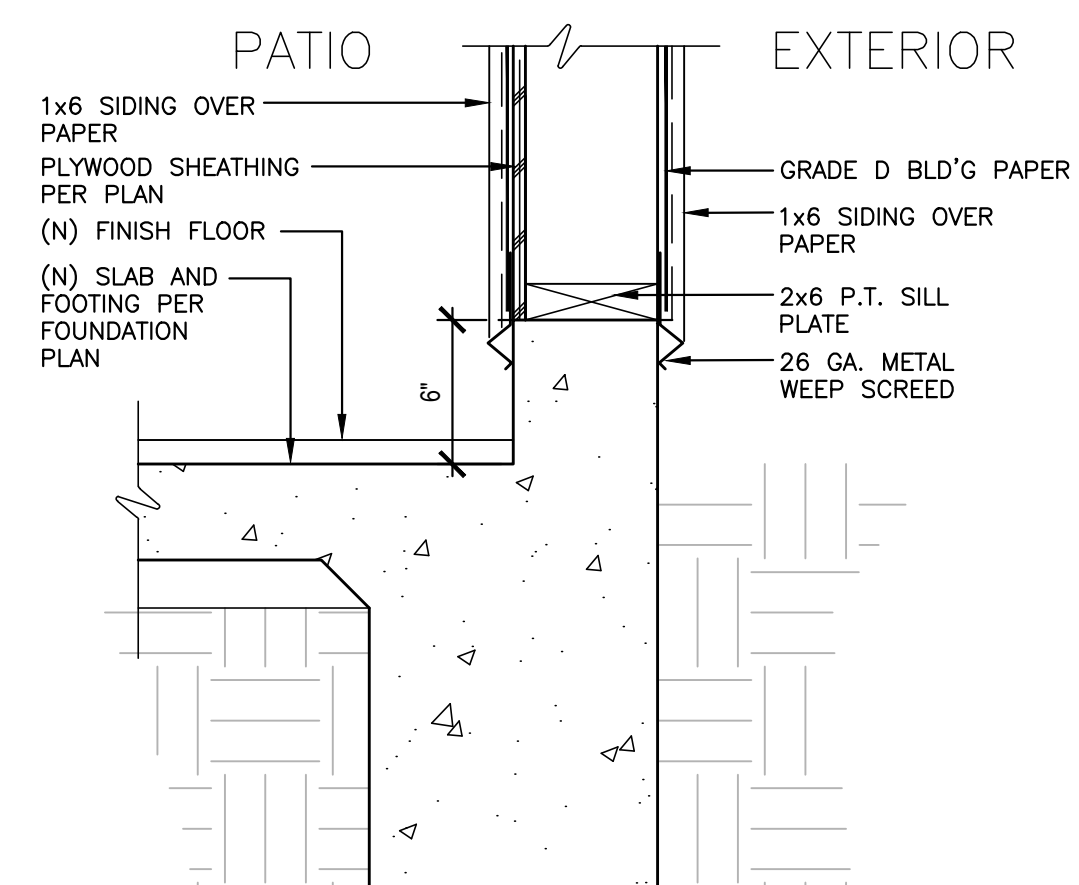


**SCREED @ 1x6 SIDING**

SCALE: 1" = 1'-0"


7

**KEY NOTES**

- 1 (N) 2x6 WOOD STUD @ 16" O.C. STUCCO WALL PER PLAN
- 2 (N) METAL MESH PANEL
- 3 (N) REAR DOOR PER SCHEDULE
- 4 (N) 6x POST PER FRAMING PLAN
- 5 (N) 4x HEADER PER FRAMING PLAN
- 6 (N) 6x BEAM PER FRAMING PLAN
- 7 (N) TPO ROOFING PER PLAN
- 8 (N) SLAB ON GRADE AND FOOTINGS PER FOUNDATION PLAN
- 9 (N) 6" CURB PER FOUNDATION PLAN
- 10 (N) 2x8 PER FRAMING PLAN
- 11 (E) REAR FASCIA AND RAIN GUTTER
- 12 (N) 1x6 SIDING
- 13 (N) 4x POST
- 14 (N) METAL MESH PANEL RAILING
- 15 (N) 2x4 CAP
- 16 (E) 8" CMU WALL

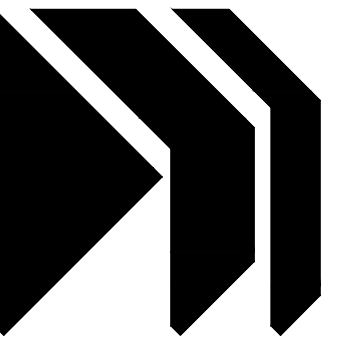

J.C. MARVICK & ASSOC., INC.  
ARCHITECTURE / PLANNING  
1827 Capital Street, suite 101  
Corona, Calif. 92878 951-808-0520

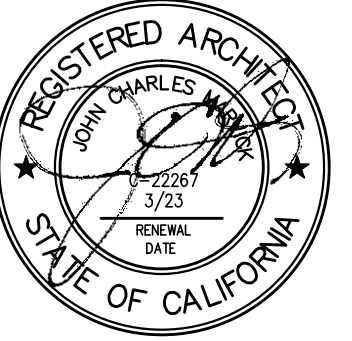

Drawings and Specifications as instruments of service are and shall remain the property of the Architect. The Drawings and Specifications shall not be used on other projects. For additions to this project by others except by agreement in writing with the Architect. Any use or reproduction of this drawing in whole or part by any means is strictly prohibited except with specific written consent of John C. Marvick, Architect.  
© COPYRIGHT 2023, JOHN C. MARVICK, ARCHITECT

**Westend Restaurant**

SITE IMPROVEMENT  
814 WEST 19TH STREET  
COSTA MESA, CA 92627

ISSUE RECORD:  
6-1-23 C.U.P. SUBMITTAL

DRAWN: C.M. CHECKED: C.M.

PROJECT NUMBER:  
22-13 WEST END RESTAURANT

SHEET TITLE:  
SECTIONS & DETAILS

SHEET NUMBER:

**A-6.0**

DATE OF LAST PRINT: 5-16-23